

MISSISSIPPI DEPARTMENT OF NATURAL RESOURCES

Bureau of Land and Water Resources

P.O. Box 10631

Jackson, Mississippi 39209

WATER WELL DRILLERS LOG

COUNTY WELL LOCATED LINCOLN	
WELL NUMBER 102781	CODED
L 7124	
DATE WELL COMPLETED 9-04-92	

PERMIT NUMBER 510
NAME OF DRILLING FIRM Easley Water Well
Brookhaven, MS 39601

NAME & MAILING ADDRESS OF LANDOWNER Randy Ratcliff			
WELL LOCATION: SEC TOWNSHIP RANGE			
<u> 1 </u>	<u> 6 </u>	<u> N </u>	<u> 7 </u>
		<u> S </u>	<u> W </u>
DISTANCE DIRECTION NEAREST TOWN			
_____ Miles of _____			
OTHER LANDMARK			
WELL PURPOSE: Home, Irrigation, Municipal, Industrial, Fish Pond, etc.			

PUMP DATA		
PUMP TYPE (Circle One): Submersible, Turbine, Jet Flowing Well, Other (Describe) <u>1/2 HP</u>		
POWER TYPE (Circle One): <input checked="" type="radio"/> Electric, Tractor, Diesel, Gasoline, Butane, Other (Describe)		
Pump Capacity (GPM) 10 GPM	No. of Stages	Setting Depth FT.
PUMP TEST		
Well yielded _____ GPM with a drawdown of _____ ft. after _____ hours of pumping		

WELL DATA		
Well Depth 65'	Casing Diameter (In.) 4"	Casing Length (Ft.) 55'
Type of Casing PVC	Hole Depth 65'	Depth to Static Water Level
TYPE OF COMPLETION: (Circle One or More): Gravel Packed, Underreamed, Telescoped, Natural Development, Open Hole, Other (Describe) <u>Home</u>		
Top of Lap Pipe or Reduction in Casing		
FEET IF TELESCOPED OR MORE THAN ONE SCREEN: USE BACK PAGE		

LOG DATA	
TYPE OF LOG RUN (Circle One): No Log Run, Electric, Gamma Ray, Density, Sonic, Neutron, Other (Describe)	
Name of Organization Running Log	


SCREEN DATA		
Diameter - Inches 4"	Length - Feet 10'	Slot Size - Inches 12
Screen Type PVC	Depth to Bottom - Feet 65'	

GEOLOGIC DATA (Office Use Only)			
Surface Elev.	Geologic Unit	Unit Thickness	Depth to Top
Subs. SWL	Date	Analysis	Aquifer Test
Driller's Remarks			

DESCRIPTION OF FORMATIONS ENCOUNTERED	FROM	TO	FORMATIONS (Continued)	FROM	TO
CLAY	0	10	RECEIVED		
SAND	10	30			
CLAY	30	65			
			JUL 05 1993		
			Dept. of Environmental Quality Office of Land & Water Resources		
			IF MORE SPACE IS NEEDED, USE BACK		

If well telescopes please
sketch and show depths.

GROUND LEVEL

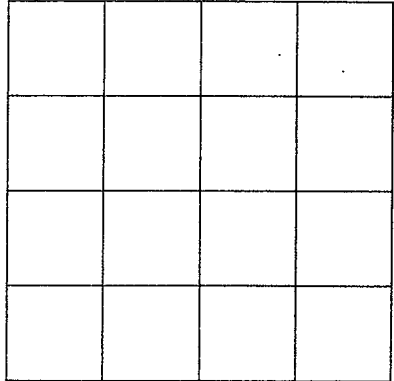

SECTION _____

Please indicate well location X.

ADDITIONAL INFORMATION

Lined area for additional information, consisting of approximately 25 horizontal lines.

If more than one screen,
show location of each on sketch.