

**MISSISSIPPI DEPARTMENT OF ENVIRONMENTAL QUALITY**

Office of Land and Water Resources

P. O. Box 10631  
Jackson, MS 39289-0631  
WATER WELL DRILLERS LOG

COUNTY WELL LOCATED <u>Lincoln</u>	
WELL NUMBER <u>L 2134</u>	CODED
DATE WELL COMPLETED <u>5-2-95</u>	

PERMIT NUMBER
NAME OF DRILLING FIRM <u>Green Water Well &amp; Supply</u>

NAME & MAILING ADDRESS OF LANDOWNER <u>Ruth Stewart</u>		
<u>735 Lower Meadville Pr. SW</u>		
<u>Boque Chitto Ms. 39629</u>		
WELL LOCATION: SEC	TOWNSHIP	RANGE
<u>7</u>	<u>6</u> <sup>N</sup> / <sub>S</sub>	<u>7</u> <sup>E</sup> / <sub>W</sub>
DISTANCE	DIRECTION	NEAREST TOWN
<u>5</u> Miles	<u>SW</u>	of <u>Brookhaven</u>
OTHER LANDMARK		
WELL PURPOSE <input checked="" type="checkbox"/> Home Irrigation, Municipal, Industrial, Fish Pond, etc.		

PUMP DATA		
PUMP TYPE (Circle One): <input checked="" type="checkbox"/> Submersible Turbine, Jet Flowing Well, Other (Describe) _____		
POWER TYPE (Circle One): <input checked="" type="checkbox"/> Electric Tractor, Diesel, Gasoline, <u>1</u> Butane, Other (Describe) _____ H/P <u>2</u>		
Pump Capacity (GPM)	No. of Stages	Setting Depth
<u>10</u>	<u>9</u>	<u>63</u> FT.
PUMP TEST		
Well yielded <u>10</u> GPM with a drawdown of <u>0</u> ft. after <u>1</u> hours of pumping		

WELL DATA		
Well Depth <u>68 ft.</u>	Casing Diameter (In.) <u>4 in.</u>	Casing Length (Ft.) <u>58 ft.</u>
Type of Casing <u>PVC</u>	Hole Depth <u>75 ft.</u>	Depth to Static Water Level <u>38 ft.</u>
TYPE OF COMPLETION: (Circle One or More): <input checked="" type="checkbox"/> Gravel Packed Underreamed, Telescoped, Natural Development, Open Hole, Other (Describe) _____		
WELL GROUTED TO A DEPTH OF <u>10</u> FEET Type Grout (circle one): Cement, Bentonite, <input checked="" type="checkbox"/> Mix		

LOG DATA	
TYPE OF LOG RUN (Circle One): <input checked="" type="checkbox"/> No Log Run, Electric, Gamma Ray, Density, Sonic, Neutron, Other (Describe) _____	
Name of Organization Running Log	

SCREEN DATA		
Diameter - Inches <u>4 in.</u>	Length - Feet <u>10 ft.</u>	Slot Size - Inches <u>.010</u>
Screen Type <u>PVC</u>	Depth to Bottom - Feet <u>68 ft.</u>	


GEOLOGIC DATA (Office Use Only)			
Surface Elev.	Geologic Unit	Unit Thickness	Depth to Top
Subs. SWL	Date	Analysis	Aquifer Test
Driller's Remarks			
Top of Lap Pipe or Reduction in Casing			
FEET		IF TELESCOPED OR MORE THAN ONE SCREEN: USE BACK PAGE	

DESCRIPTION OF FORMATIONS ENCOUNTERED	FROM	TO
<u>red clay</u>	<u>0</u>	<u>14</u>
<u>red sand</u>	<u>14</u>	<u>60</u>
<u>sand &amp; gravel</u>	<u>60</u>	<u>68</u>
<u>white clay</u>	<u>68</u>	<u>74</u>

FORMATIONS (Continued)	FROM	TO
<b>RECEIVED</b>		
<b>JUN 30 1995</b>		
Dept. of Environmental Quality Office of Land & Water Resources		
IF MORE SPACE IS NEEDED, USE BACK		

If well telescopes please sketch and show depths.

GROUND LEVEL

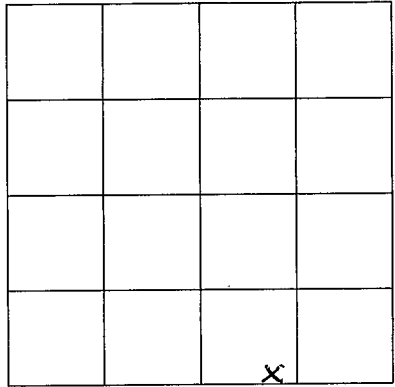

SECTION 7

Please indicate well location X.

ADDITIONAL INFORMATION

Lined area for additional information.

If more than one screen, show location of each on sketch.