

MISSISSIPPI DEPARTMENT OF ENVIRONMENTAL QUALITY

Office of Land and Water Resources

COUNTY WELL LOCATED <i>Lauderdale</i>	
WELL NUMBER <i>L 2143</i>	CODED
DATE WELL COMPLETED <i>5-21-96</i>	

PERMIT NUMBER Gretn Water Well & Supply
NAME OF WELL 1818 Friedale Dr. SE Bogue Chitto, MS 39629

P. O. Box 10631
Jackson, MS 39289-0631
WATER WELL DRILLERS LOG

NAME & MAILING ADDRESS OF LANDOWNER <i>Gary Adams</i>		
<i>1593 Shelby Ln</i>		
<i>Bogue Chitto MS</i>		
WELL LOCATION: SEC	TOWNSHIP	RANGE
<i>30</i>	<i>6</i>	<i>7</i>
	<i>N</i>	<i>W</i>
DISTANCE	DIRECTION	NEAREST TOWN
<i>7</i> Miles	<i>SW</i>	<i>Brookhaven</i>
OTHER LANDMARK		
WELL PURPOSE: <input checked="" type="radio"/> Home, Irrigation, Municipal, Industrial, Fish Pond, etc.		

PUMP DATA		
PUMP TYPE (Circle One): <input checked="" type="radio"/> Submersible Turbine, Jet, Flowing Well, Other (Describe) _____		
POWER TYPE (Circle One): <input checked="" type="radio"/> Electric, Tractor, Diesel, Gasoline, Butane, Other (Describe) _____ H/P <i>1/2</i>		
Pump Capacity (GPM) <i>10</i>	No. of Stages <i>9</i>	Setting Depth <i>55</i> FT.
PUMP TEST		
Well yielded <i>10</i> GPM with a drawdown of <i>0</i> ft. after <i>1</i> hours of pumping		

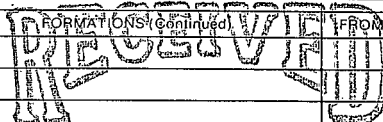
WELL DATA		
Well Depth <i>78</i>	Casing Diameter (In.) <i>4</i>	Casing Length (Ft.) <i>68</i>
Type of Casing <i>PVC</i>	Hole Depth <i>83</i>	Depth to Static Water Level <i>32</i>
TYPE OF COMPLETION: (Circle One or More): <input checked="" type="radio"/> Gravel Packed, Underreamed, Telescoped, Natural Development, Open Hole, Other (Describe) _____		
WELL GROUTED TO A DEPTH OF <i>10</i> FEET Type Grout (circle one): Cement, Bentonite, <input checked="" type="radio"/> Mix		

LOG DATA	
TYPE OF LOG RUN (Circle One): <input checked="" type="radio"/> No Log Run Electric, Gamma Ray, Density, Sonic, Neutron, Other (Describe) _____	
Name of Organization Running Log	

SCREEN DATA		
Diameter - Inches <i>4</i>	Length - Feet <i>10</i>	Slot Size - Inches <i>.010</i>
Screen Type <i>PVC</i>	Depth to Bottom - Feet <i>78</i>	

GEOLOGIC DATA (Office Use Only)			
Surface Elev.	Geologic Unit	Unit Thickness	<input checked="" type="radio"/> Depth to Top
Subs. SWL	Date	Analysis	Aquifer Test
Driller's Remarks			
Top of Lap Pipe or Reduction in Casing			
FEET		IF TELESCOPED OR MORE THAN ONE SCREEN: USE BACK PAGE	

DESCRIPTION OF FORMATIONS ENCOUNTERED	FROM	TO
<i>Red Clay</i>	<i>0</i>	<i>18</i>
<i>Sand</i>	<i>18</i>	<i>38</i>
<i>Sand & Gravel</i>	<i>38</i>	<i>78</i>
<i>White Clay</i>	<i>78</i>	<i>83</i>


JUN 21 1996
 Dept. of Environmental Quality
 Office of Land & Water Resources
 IF MORE SPACE IS NEEDED, USE BACK

If well telescopes please sketch and show depths.

GROUND LEVEL

		X	

SECTION 30

Please indicate well location X.

ADDITIONAL INFORMATION

If more than one screen,
show location of each on sketch.