

**MISSISSIPPI DEPARTMENT OF ENVIRONMENTAL  
QUALITY**

Office of Land and Water Resources

P. O. Box 10631  
Jackson, MS 39289-0631  
**WATER WELL DRILLERS LOG**

COUNTY WELL LOCATED <u>Lincoln</u>	
WELL NUMBER <u>2146</u>	CODED
DATE WELL COMPLETED <u>6-8-96</u>	

PERMIT NUMBER
NAME OF DRILLING FIRM <u>Green Water Well &amp; Supply</u>

NAME & MAILING ADDRESS OF LANDOWNER <u>Willie Mc Lee</u>		
<u>1742 Calvary Rd SW</u>		
<u>Bogue Chitto MS</u>		
WELL LOCATION: SEC	TOWNSHIP	RANGE
<u>27</u>	<u>6</u> <sup>(N)</sup> S	<u>7</u> <sup>(E)</sup> W
DISTANCE <u>1 1/2</u> Miles	DIRECTION <u>NW</u>	NEAREST TOWN <u>of Bogue Chitto</u>
OTHER LANDMARK		
WELL PURPOSE <input checked="" type="checkbox"/> Home Irrigation, Municipal, Industrial, Fish Pond, etc.		

PUMP DATA		
PUMP TYPE (Circle One): <input checked="" type="checkbox"/> Submersible, Turbine, Jet, Flowing Well, Other (Describe) _____		
POWER TYPE (Circle One): <input checked="" type="checkbox"/> Electric, Tractor, Diesel, Gasoline, Butane, Other (Describe) _____ H/P <u>1/2</u>		
Pump Capacity (GPM) <u>10</u>	No. of Stages <u>9</u>	Setting Depth <u>70</u> FT.
PUMP TEST		
Well yielded <u>10</u> GPM with a drawdown of <u>10</u> ft. after <u>1</u> hours of pumping		

WELL DATA		
Well Depth <u>77</u>	Casing Diameter (In.) <u>4 in.</u>	Casing Length (Ft.) <u>57</u>
Type of Casing <u>PVC</u>	Hole Depth <u>85</u>	Depth to Static Water Level <u>40'</u>
TYPE OF COMPLETION: (Circle One or More): <input checked="" type="checkbox"/> Gravel Packed, Underreamed, Telescoped, Natural Development, Open Hole, Other (Describe) _____		
WELL GROUTED TO A DEPTH OF <u>5</u> FEET Type Grout (circle one): Cement, Bentonite, or <input checked="" type="checkbox"/> Mix		

LOG DATA	
TYPE OF LOG RUN (Circle One): <input checked="" type="checkbox"/> No Log Run, Electric, Gamma Ray, Density, Sonic, Neutron, Other (Describe) _____	
Name of Organization Running Log	

SCREEN DATA		
Diameter - Inches <u>4 in.</u>	Length - Feet <u>20 ft.</u>	Slot Size - Inches <u>.010</u>
Screen Type <u>PVC</u>	Depth to Bottom - Feet <u>77'</u>	


GEOLOGIC DATA (Office Use Only)			
Surface Elev.	Geologic Unit	Unit Thickness	Depth to Top
Subs. SWL	Date	Analysis	Aquifer Test
Driller's Remarks			
Top of Lap Pipe or Reduction in Casing			
FEET			
IF TELESCOPED OR MORE THAN ONE SCREEN: USE BACK PAGE			

DESCRIPTION OF FORMATIONS ENCOUNTERED	FROM	TO
<u>Red Clay</u>	<u>0</u>	<u>38</u>
<u>Sand &amp; Gravel</u>	<u>38</u>	<u>77</u>
<u>White Clay</u>	<u>77</u>	<u>85</u>

FORMATIONS (Continued)	FROM	TO
<b>RECEIVED</b>		
<b>FEB 07 1997</b>		
Dept. of Environmental Quality Office of Land & Water Resources		
IF MORE SPACE IS NEEDED, USE BACK		

If well telescopes please  
sketch and show depths.

GROUND LEVEL

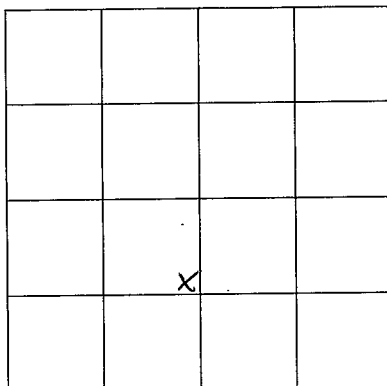

SECTION 27

Please indicate well location X.

ADDITIONAL INFORMATION

If more than one screen,  
show location of each on sketch.