

MISSISSIPPI DEPARTMENT OF ENVIRONMENTAL QUALITY

Office of Land and Water Resources

P. O. Box 10631

Jackson, MS 39289-0631

WATER WELL DRILLERS LOG

COUNTY WELL LOCATED <i>Lincoln</i>	
WELL NUMBER <i>L 2178</i>	CODED
DATE WELL COMPLETED <i>12-18-98</i>	

Green Water Well & Supply 1318 Pricedale Dr. SE Bogie Chitto, MS 39629
NAME OF DRILLING FIRM

NAME & MAILING ADDRESS OF LANDOWNER <i>Roy Julian</i>			
<i>880 Atlantis Loop</i>			
<i>Bogie Chitto</i>			
WELL LOCATION:	SEC	TOWNSHIP	RANGE
	<i>7</i>	<i>6 S</i>	<i>7 W</i>
DISTANCE	DIRECTION	NEAREST TOWN	
<i>2</i> Miles	<i>E</i>	<i>West Lincoln</i>	
OTHER LANDMARK			
WELL PURPOSE: <input checked="" type="checkbox"/> Home Irrigation, <input type="checkbox"/> Municipal, <input type="checkbox"/> Industrial, <input type="checkbox"/> Fish Pond, etc.			

PUMP DATA		
PUMP TYPE (Circle One): <input checked="" type="checkbox"/> Submersible, <input type="checkbox"/> Turbine, <input type="checkbox"/> Jet, <input type="checkbox"/> Flowing Well, Other (Describe) _____		
POWER TYPE (Circle One): <input checked="" type="checkbox"/> Electric, <input type="checkbox"/> Tractor, <input type="checkbox"/> Diesel, <input type="checkbox"/> Gasoline, <input type="checkbox"/> Butane, Other (Describe) _____ H/P <i>1/2</i>		
Pump Capacity (GPM) <i>10</i>	No. of Stages <i>9</i>	Setting Depth <i>49</i> FT.
PUMP TEST		
Well yielded <i>10</i> GPM with a drawdown of <i>10</i> ft. after <i>1</i> hours of pumping		

WELL DATA		
Well Depth <i>50'</i>	Casing Diameter (In.) <i>4"</i>	Casing Length (Ft.) <i>30'</i>
Type of Casing <i>PVC</i>	Hole Depth <i>60</i>	Depth to Static Water Level <i>28'</i>

LOG DATA	
TYPE OF LOG RUN (Circle One): <input type="checkbox"/> Electric, <input type="checkbox"/> Gamma Ray, <input type="checkbox"/> Density, <input type="checkbox"/> Sonic, <input checked="" type="checkbox"/> No Log Run, <input type="checkbox"/> Neutron, Other (Describe) _____	
Name of Organization Running Log	


TYPE OF COMPLETION: (Circle One or More):
 Gravel Packed, Underreamed, Telescoped,
 Natural Development, Open Hole, Other

GEOLOGIC DATA (Office Use Only)			
Surface Elev.	Geologic Unit	Unit Thickness	Depth to Top
Subs. SWL	Date	Analysis	Aquifer Test
Driller's Remarks			
Top of Lap Pipe or Reduction in Casing			
FEET		IF TELESCOPED OR MORE THAN ONE SCREEN: USE BACK PAGE	

WELL GROUTED TO A DEPTH OF *10* FEET
 Type Grout (circle one): Cement, Bentonite, or Mix

SCREEN DATA		
Diameter - Inches <i>4"</i>	Length - Feet <i>20'</i>	Slot Size - Inches <i>.010</i>
Screen Type <i>PVC</i>	Depth to Bottom - Feet <i>50'</i>	

DESCRIPTION OF FORMATIONS ENCOUNTERED	FROM	TO
<i>Red Clay</i>	<i>0</i>	<i>22</i>
<i>Sand</i>	<i>22</i>	<i>50</i>
<i>White Clay</i>	<i>50</i>	<i>60</i>

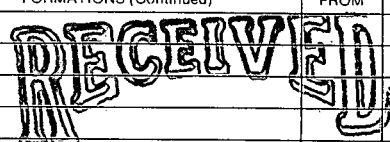FORMATIONS (Continued)	FROM	TO
 RECEIVED JAN 25 1999		
Dept. of Environmental Quality Office of Land & Water Resources		

IF MORE SPACE IS NEEDED, USE BACK

If well telescopes please sketch and show depths.


GROUND LEVEL

			X

SECTION 7

Please indicate well location X.

ADDITIONAL INFORMATION

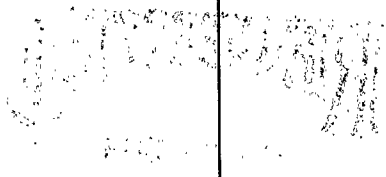

If more than one screen, show location of each on sketch.