



If well telescopes please sketch and show depths.


GROUND LEVEL

	X		

SECTION 32

Please indicate well location X.

ADDITIONAL INFORMATION

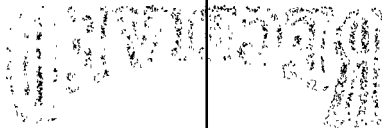

If more than one screen,  
show location of each on sketch.