

MISSISSIPPI DEPARTMENT OF NATURAL RESOURCES

Bureau of Land and Water Resources

P.O. Box 10631

Jackson, Mississippi 39209

WATER WELL DRILLERS LOG

COUNTY WELL LOCATED Lincoln	
WELL NUMBER L 2191	CODED
DATE WELL COMPLETED 4-30-99	

PERMIT NUMBER 510
NAME OF DRILLING FIRM Easley Waterwell
B'haven, MS 39601

NAME & MAILING ADDRESS OF LANDOWNER Anthony Knox		
WELL LOCATION: SEC	TOWNSHIP	RANGE
26	6 ^(N)	7 ^(E) _(W)
DISTANCE	DIRECTION	NEAREST TOWN
OTHER LANDMARK		
WELL PURPOSE: Home, Irrigation, Municipal, Industrial, Fish Pond, etc.		

PUMP DATA		
PUMP TYPE (Circle One): <u>Submersible</u> , Turbine, Jet, Flowing Well, Other (Describe) _____		
POWER TYPE (Circle One): Electric, Tractor, Diesel, Gasoline, Butane, Other (Describe) _____		
Pump Capacity (GPM)	No. of Stages	Setting Depth FT.
PUMP TEST		
Well yielded _____ GPM with a drawdown of _____ ft. after _____ hours of pumping		

WELL DATA		
Well Depth 250'	Casing Diameter (In.) 4"	Casing Length (Ft.) 240'
Type of Casing PVC	Hole Depth 250'	Depth to Static Water Level
TYPE OF COMPLETION: (Circle One or More): <u>Natural Development</u> , Gravel Packed, Underreamed, Telescoped, Open Hole, Other (Describe) _____		
Top of Lap Pipe or Reduction in Casing FEET <input type="checkbox"/> IF TELESCOPED OR MORE THAN ONE SCREEN: USE BACK PAGE		

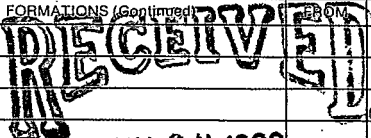
LOG DATA	
TYPE OF LOG RUN (Circle One): No Log Run, Electric, Gamma Ray, Density, Sonic, Neutron, Other (Describe) _____	
Name of Organization Running Log	

SCREEN DATA		
Diameter - Inches 4"	Length - Feet 10'	Slot Size - Inches 010
Screen Type PVC	Depth to Bottom - Feet	

GEOLOGIC DATA (Office Use Only)			
Surface Elev.	Geologic Unit	Unit Thickness	Depth to Top
Subs. SWL	Date	Analysis	Aquifer Test

Driller's Remarks

DESCRIPTION OF FORMATIONS ENCOUNTERED	FROM	TO
Clay	0	20
Gravel	20	60
Clay	60	230
Sand	230	250

 JUN 22 1999 Dept. of Environmental Quality Office of Land & Water Resources
IF MORE SPACE IS NEEDED, USE BACK

If well telescopes please
sketch and show depths.

GROUND LEVEL

SECTION _____

Please indicate well location X.

ADDITIONAL INFORMATION

If more than one screen,
show location of each on sketch.