




If well telescopes please  
sketch and show depths.



GROUND LEVEL

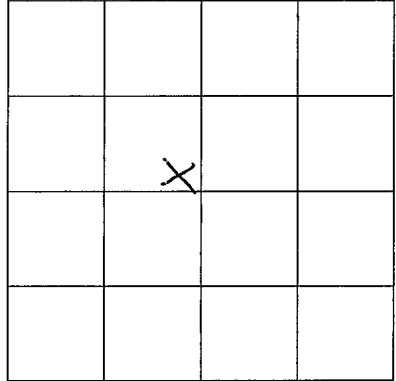

SECTION 17

Please indicate well location X.

ADDITIONAL INFORMATION

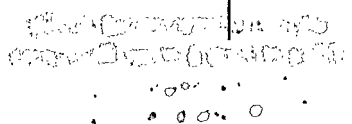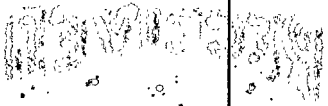

If more than one screen,  
show location of each on sketch.