

6/19/00

MISSISSIPPI DEPARTMENT OF ENVIRONMENTAL QUALITY

Office of Land and Water Resources

P. O. Box 10631
Jackson, MS 39289-0631

WATER WELL DRILLERS LOG

COUNTY WELL LOCATED
Lincoln

WELL NUMBER CODED
L-2215

DATE WELL COMPLETED
6-19-00

DRILLER NUMBER
Green Water Well & Supply

NAME OF DRILLING COMPANY
1318 Prichard Dr. SE
Bogue Chitto, MS 39629

NAME & MAILING ADDRESS OF LANDOWNER
Helen Dixon
180 Springfield Jr.
Bogue Chitto

WELL LOCATION: SEC TOWNSHIP RANGE
22 6 N 7 E
S W

DISTANCE DIRECTION NEAREST TOWN
6 Miles S of Brookhaven

OTHER LANDMARK

WELL PURPOSE: Home, Irrigation, Municipal, Industrial, Fish Pond, etc.

PUMP DATA

PUMP TYPE (Circle One):
 Submersible, Turbine, Jet, Flowing Well,
Other (Describe) _____

POWER TYPE (Circle One):
 Electric, Tractor, Diesel, Gasoline, Butane,
Other (Describe) _____ H/P 42

Pump Capacity (GPM) No. of Stages Setting Depth
10 9 54 FT.

PUMP TEST

Well yielded 10 GPM with
a drawdown of 5 ft.
after 1 hours of pumping

WELL DATA

Well Depth Casing Diameter (In.) Casing Length (Ft.)
55 4 35

Type of Casing Hole Depth Depth to Static Water Level
PVC 65 26

TYPE OF COMPLETION: (Circle One or More):
 Gravel Packed, Underreamed, Telescoped,
Natural Development, Open Hole, Other
(Describe) _____

WELL GROUTED TO A DEPTH OF 10 FEET
Type Grout (circle one): Cement, Bentonite, Mix

LOG DATA

TYPE OF LOG RUN (Circle One):
Electric, Gamma Ray, Density, Sonic, No Log Run, Neutron,
Other (Describe) _____

Name of Organization Running Log

SCREEN DATA

Diameter - Inches Length - Feet Slot Size - Inches
4 20 .010

Screen Type Depth to Bottom - Feet
PVC 55

GEOLOGIC DATA (Office Use Only)

Surface Elev.	Geologic Unit	Unit Thickness	Depth to Top
Subs. SWL	Date	Analysis	Aquifer Test

Driller's Remarks

Top of Lap Pipe or Reduction in Casing.

IF TELESKOPED OR MORE THAN ONE SCREEN, USE BACK PAGE

DESCRIPTION OF FORMATIONS ENCOUNTERED	FROM	TO	FORMATIONS (Continued)	FROM	TO
<u>Red Clay</u>	<u>0</u>	<u>12</u>	<u>12</u>	<u>12</u>	<u>56</u>
<u>Sand or Gravel</u>	<u>12</u>	<u>56</u>	<u>56</u>	<u>65</u>	<u>65</u>
<u>White Clay</u>	<u>56</u>	<u>65</u>			

JUL 30 2000

Don't allow...
...

IF MORE SPACE IS NEEDED, USE BACK.

If well telescopes please sketch and show depths.


GROUND LEVEL

X			

SECTION 22

Please indicate well location X.

ADDITIONAL INFORMATION

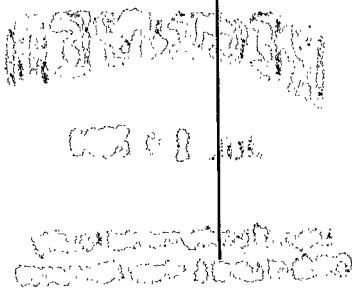

Hand-drawn sketch of a well screen or structure, showing a vertical shaft with a screen at the bottom and some surrounding ground level.

If more than one screen, show location of each on sketch.