

PERMIT NUMBER	Grenn Water Well & Supply
NAME OF BILLING PARTY	Calo Dr. SE Rogue Chino, MS 39029

Office of Land and Water Resources

**P. O. Box 10631
Jackson, MS 39289-0631
WATER WELL DRILLERS LOG**

NAME & MAILING ADDRESS OF LANDOWNER

Gerald Wallace

41 McCaffery Tr.

Bogue Chitto

WELL LOCATION	SEC	TOWNSHIP	RANGE
	27	6 N S	7 E W

DISTANCE 2 Miles DIRECTION NW NEAREST TOWN of Bogue Chitto

OTHER LANDMARK

WELL PURPOSE Home, Irrigation, Municipal, Industrial, Fish Pond, etc.

PUMP DATA		
PUMP TYPE (Circle One):		
Submersible	Turbine	Jet
Other (Describe) _____		
POWER TYPE (Circle One):		
Electric	Tractor	Diesel
Gasoline		
Butane		
Other (Describe) _____		
H/P <u>1/2</u>		
Pump Capacity (GPM)	No of Stages	Setting Depth
<u>10</u>	<u>9</u>	<u>85</u> FT.
PUMP TEST		
Well yielded <u>10</u> GPM with		
a drawdown of <u>0</u> ft.		
after <u>1</u> hours of pumping		

LOG DATA

TYPE OF LOG RUN (Circle One): No Log Run.
Electric, Gamma Ray, Density, Sonic, Neutron,
Other (Describe) _____

Name of Organization Running Log _____

GEOLOGIC DATA (Office Use Only)

Surface Elev	Geologic Unit	Unit Thickness	Depth to Top
Subs SWL	Date	Analysis	Aquifer Test


Driller's Remarks	
Top of Lap Pipe or Reduction in Casing	
FEET	IF TELESCOPED OR MORE THAN ONE SCREEN: USE BACK PAGE

SCREEN DATA		
Diameter - Inches 4	Length - Feet 10	Slot Size - Inches .010
Screen Type PVC		Depth to Bottom - Feet 75

[illegible]

If well telescopes please
sketch and show depths.

GROUND LEVEL

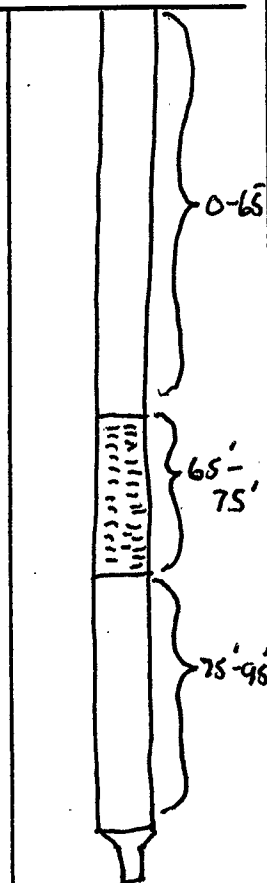

	X		

SECTION 27

Please indicate well location X.

ADDITIONAL INFORMATION

If more than one screen,
show location of each on sketch.