

**MISSISSIPPI DEPARTMENT OF ENVIRONMENTAL QUALITY**

Office of Land and Water Resources

P. O. Box 10631

Jackson, MS 39289-0631

**WATER WELL DRILLERS LOG**

COUNTY WELL LOCATED <i>Lincoln</i>	
WELL NUMBER <b>L 2228</b>	CODED
DATE WELL COMPLETED <i>11/31/01</i>	

<b>Ground Water Well &amp; Supply</b> 1316 Pricedale Dr. SE BOQUE CHITTO, MS 39029
NAME OF DRILLING FIRM <b>BOQUE CHITTO, MS 39029</b>

NAME & MAILING ADDRESS OF LANDOWNER <i>Frank Barrios</i>		
<i>1600 Big Creek Dr.</i>		
<i>Boque Chitto</i>		
WELL LOCATION: SEC	TOWNSHIP	RANGE
<i>35</i>	<i>6 N</i>	<i>7 E</i>
DISTANCE	DIRECTION	NEAREST TOWN
<i>1</i> Miles	<i>NW</i>	of <i>Boque Chitto</i>
OTHER LANDMARK		
WELL PURPOSE: <input checked="" type="checkbox"/> Home, <input type="checkbox"/> Irrigation, <input type="checkbox"/> Municipal, <input type="checkbox"/> Industrial, <input type="checkbox"/> Fish Pond, etc.		

<b>PUMP DATA</b>		
PUMP TYPE (Circle One): <input checked="" type="checkbox"/> Submersible, <input type="checkbox"/> Turbine, <input type="checkbox"/> Jet, <input type="checkbox"/> Flowing Well, Other (Describe) _____		
POWER TYPE (Circle One): <input checked="" type="checkbox"/> Electric, <input type="checkbox"/> Tractor, <input type="checkbox"/> Diesel, <input type="checkbox"/> Gasoline, <input type="checkbox"/> Butane, Other (Describe) _____ H/P <i>42</i>		
Pump Capacity (GPM) <i>10</i>	No. of Stages <i>9</i>	Setting Depth <i>45</i> FT.
PUMP TEST		
Well yielded <i>14</i> GPM with a drawdown of <i>0</i> ft. after <i>1</i> hours of pumping		

<b>WELL DATA</b>		
Well Depth <i>83</i>	Casing Diameter (In.) <i>4</i>	Casing Length (Ft.) <i>70</i>
Type of Casing <i>PVC</i>	Hole Depth <i>86</i>	Depth to Static Water Level <i>15</i>

<b>LOG DATA</b>	
TYPE OF LOG RUN (Circle One): <input checked="" type="checkbox"/> No Log Run, <input type="checkbox"/> Electric, <input type="checkbox"/> Gamma Ray, <input type="checkbox"/> Density, <input type="checkbox"/> Sonic, <input type="checkbox"/> Neutron, Other (Describe) _____	
Name of Organization Running Log	

TYPE OF COMPLETION: (Circle One or More):  
 Gravel Packed,  Underreamed,  Telescoped,  
 Natural Development,  Open Hole,  Other  
 (Describe) \_\_\_\_\_

<b>GEOLOGIC DATA (Office Use Only)</b>			
Surface Elev.	Geologic Unit	Unit Thickness	Depth to Top
Subs. SWL	Date	Analysis	Aquifer Test

WELL GROUTED TO A DEPTH OF *10* FEET  
 Type Grout (circle one): Cement, Bentonite, or  Mix

<b>SCREEN DATA</b>		
Diameter - Inches <i>4</i>	Length - Feet <i>10</i>	Slot Size - Inches <i>.010</i>
Screen Type <i>PVC</i>	Depth to Bottom - Feet <i>80</i>	

Driller's Remarks	
Top of Lap Pipe or Reduction in Casing	
FEET	IF TELESCOPED OR MORE THAN ONE SCREEN: USE BACK PAGE


DESCRIPTION OF FORMATIONS ENCOUNTERED	FROM	TO
<i>Red Clay</i>	<i>0</i>	<i>5</i>
<i>Sand or Gravel</i>	<i>5</i>	<i>82</i>
<i>White Clay</i>	<i>82</i>	<i>86</i>

FORMATIONS (Continued)	FROM	TO

**REC'D JUN 13 2001**

If well telescopes please  
sketch and show depths.

GROUND LEVEL

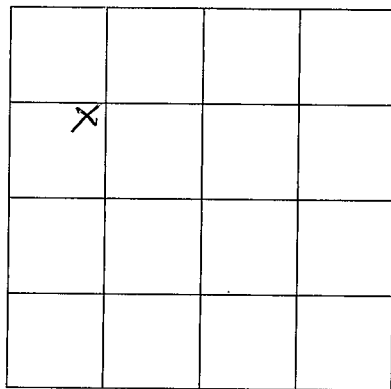

SECTION 35

Please indicate well location X.

ADDITIONAL INFORMATION

If more than one screen,  
show location of each on sketch.