

MISSISSIPPI DEPARTMENT OF ENVIRONMENTAL QUALITY
Office of Land and Water Resources

COUNTY WELL LOCATED
Lincoln

WELL NUMBER 1, 2229 CODED

DATE WELL COMPLETED
1/15/01

Ground Water Well & Supply
1318 Pricedale Dr. SE
Bogue Chitto, MS 39629

P. O. Box 10631
Jackson, MS 39289-0631
WATER WELL DRILLERS LOG

NAME & MAILING ADDRESS OF LANDOWNER
Marty Dunn
353 Springfield Ave SW
Bogue Chitto

WELL LOCATION: SEC 21 TOWNSHIP 6 RANGE 7
S N W E

DISTANCE 3 Miles DIRECTION NW of NEAREST TOWN Bogue Ch. Ho

OTHER LANDMARK

WELL PURPOSE: Home Irrigation, Municipal, Industrial, Fish Pond, etc.

PUMP DATA

PUMP TYPE (Circle One):
 Submersible, Turbine, Jet, Flowing Well,
Other (Describe) _____

POWER TYPE (Circle One):
 Electric, Tractor, Diesel, Gasoline, Butane,
Other (Describe) _____ H/P 1/2

Pump Capacity (GPM) <u>10</u>	No. of Stages <u>9</u>	Setting Depth <u>62</u> FT.
----------------------------------	---------------------------	--------------------------------

PUMP TEST

Well yielded 12 GPM with
a drawdown of 5 ft.
after 1 hours of pumping

WELL DATA

Well Depth <u>76</u>	Casing Diameter (In.) <u>4</u>	Casing Length (Ft.) <u>56</u>
Type of Casing <u>PVC</u>	Hole Depth, <u>85</u>	Depth to Static Water Level <u>32</u>

TYPE OF COMPLETION: (Circle One or More):
 Gravel Packed, Underreamed, Telescoped,
 Natural Development, Open Hole, Other
(Describe) _____

LOG DATA

TYPE OF LOG RUN (Circle One): No Log Run,
Electric, Gamma Ray, Density, Sonic, Neutron,
Other (Describe) _____

Name of Organization Running Log

WELL GROUTED TO A DEPTH OF 10 FEET
Type Grout (circle one): Cement, Bentonite, or Mix

GEOLOGIC DATA (Office Use Only)

Surface Elev.	Geologic Unit	Unit Thickness	Depth to Top
Subs. SWL	Date	Analysis	Aquifer Test

SCREEN DATA

Diameter - Inches <u>4</u>	Length - Feet <u>20</u>	Slot Size - Inches <u>.010</u>
Screen Type <u>PVC</u>	Depth to Bottom - Feet <u>76</u>	

Driller's Remarks

Top of Lap Pipe or Reduction in Casing

FEET IF TELESCOPED OR MORE THAN ONE SCREEN: USE BACK PAGE


DESCRIPTION OF FORMATIONS ENCOUNTERED	FROM	TO
<u>Red Clay</u>	<u>0</u>	<u>15</u>
<u>Sand & Gravel</u>	<u>30</u>	<u>76</u>
<u>White Clay</u>	<u>76</u>	<u>85</u>

FORMATIONS (Continued)	FROM	TO

REC'D JUN 13 2001

If well telescopes please
sketch and show depths.

GROUND LEVEL

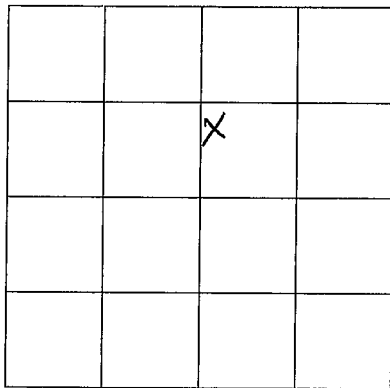

SECTION 21

Please indicate well location X.

ADDITIONAL INFORMATION

If more than one screen,
show location of each on sketch.