

MISSISSIPPI DEPARTMENT OF ENVIRONMENTAL QUALITY
Office of Land and Water Resources

P. O. Box 10631
 Jackson, MS 39289-0631
WATER WELL DRILLERS LOG

COUNTY WELL LOCATED
Lincoln
 WELL NUMBER
407014
 CODED
L-2230
 DATE WELL COMPLETED
8-2-20-01

PERMIT NUMBER
510
 NAME OF DRILLING FIRM
Easley Waterwell
B'haven MS 39601

NAME & MAILING ADDRESS OF LANDOWNER
Wooten Realty
1235 Arlington Drive
Bozue Chitto MS 39629
 WELL LOCATION: SEC _____ TOWNSHIP _____ RANGE _____
20 6 N 7 W
 DISTANCE _____ MILES _____ of _____
 DIRECTION _____ NEAREST TOWN _____
 OTHER LANDMARK _____
 WELL PURPOSE: Home, Irrigation, Municipal, Industrial, Fish Pond, etc.

PUMP DATA

PUMP TYPE (Circle One):
 Submersible, Turbine, Jet, Flowing Well,
 Other (Describe) _____
 POWER TYPE (Circle One):
 Electric, Tractor, Diesel, Gasoline, Butane,
 Other (Describe) _____ H/P _____
 Pump Capacity (GPM) _____ No. of Stages _____ Setting Depth _____ FT.
 PUMP TEST
 Well yielded _____ GPM with
 a drawdown of _____ ft.
 after _____ hours of pumping

WELL DATA

Well Depth <u>80</u>	Casing Diameter (In.) <u>4"</u>	Casing Length (Ft.) <u>60</u>
Type of Casing <u>PVC</u>	Hole Depth <u>#00</u>	Depth to Static Water Level

TYPE OF COMPLETION: (Circle One or More):
 Gravel Packed, Underreamed, Telescoped,
 Natural Development, Open Hole, Other
 (Describe) _____

WELL GROUTED TO A DEPTH OF 10 FEET
 Type Grout (circle one): Cement, Bentonite, or Mix

LOG DATA

TYPE OF LOG RUN (Circle One):
 No Log Run, Electric, Gamma Ray, Density, Sonic, Neutron,
 Other (Describe) _____
 Name of Organization Running Log _____

SCREEN DATA

Diameter - Inches <u>4"</u>	Length - Feet <u>20'</u>	Slot Size - Inches <u>012</u>
Screen Type <u>PVC</u>	Depth to Bottom - Feet	

GEOLOGIC DATA (Office Use Only)

Surface Elev.	Geologic Unit	Unit Thickness	Depth to Top
Subs. SWL	Date	Analysis	Aquifer Test

Driller's Remarks _____

 Top of Lap Pipe or Reduction in Casing _____
FEET IF TELESCOPED OR MORE THAN ONE SCREEN: USE BACK PAGE

DESCRIPTION OF FORMATIONS ENCOUNTERED	FROM	TO
<u>Clay</u>	<u>0</u>	<u>10</u>
<u>Sand</u>	<u>10</u>	<u>80</u>
<u>Clay</u>	<u>80</u>	<u>100</u>


FORMATIONS (Continued)	FROM	TO

REC'D JUN 13 2001

IF MORE SPACE IS NEEDED, USE BACK

If well telescopes please
sketch and show depths.

GROUND LEVEL

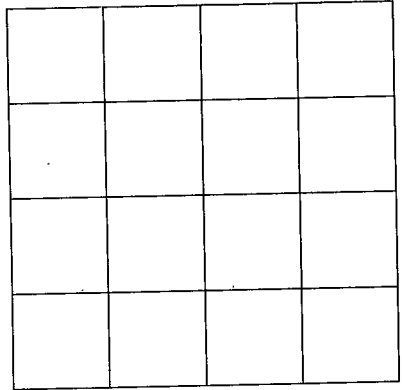

SECTION _____

Please indicate well location X.

ADDITIONAL INFORMATION

If more than one screen,
show location of each on sketch.