

**MISSISSIPPI DEPARTMENT OF ENVIRONMENTAL QUALITY**

Office of Land and Water Resources

P. O. Box 10631  
Jackson, MS 39289-0631

**WATER WELL DRILLERS LOG**

COUNTY WELL LOCATED <i>Lincoln</i>	
WELL NUMBER <i>312514</i>	CODED
<i>L-2235</i>	
DATE WELL COMPLETED <i>7-19-00</i>	

PERMIT NUMBER <i>510</i>
NAME OF DRILLING FIRM <i>Easley Waterwell</i>
<i>Brookhaven MS 39601</i>

NAME & MAILING ADDRESS OF LANDOWNER <i>David Wolf</i>			
<i>1025 Eagle Trail</i>			
<i>Brookhaven MS 39601</i>			
WELL LOCATION:	SEC	TOWNSHIP	RANGE
	<i>7</i>	<i>6 S</i>	<i>2 E</i>
DISTANCE	DIRECTION	NEAREST TOWN	
		<i>W</i>	
Miles _____ of _____			
OTHER LANDMARK			
WELL PURPOSE: <input checked="" type="checkbox"/> Home Irrigation, <input type="checkbox"/> Municipal, <input type="checkbox"/> Industrial, <input type="checkbox"/> Fish Pond, etc.			

<b>PUMP DATA</b>		
PUMP TYPE (Circle One): <input checked="" type="checkbox"/> Submersible, <input type="checkbox"/> Turbine, <input type="checkbox"/> Jet, <input type="checkbox"/> Flowing Well, Other (Describe) _____		
POWER TYPE (Circle One): <input checked="" type="checkbox"/> Electric, <input type="checkbox"/> Tractor, <input type="checkbox"/> Diesel, <input type="checkbox"/> Gasoline, <input type="checkbox"/> Butane, Other (Describe) _____ H/P _____		
Pump Capacity (GPM)	No. of Stages	Setting Depth  FT.
PUMP TEST		
Well yielded _____ GPM with a drawdown of _____ ft. after _____ hours of pumping		

<b>WELL DATA</b>		
Well Depth <i>200'</i>	Casing Diameter (In.) <i>PVC 4</i>	Casing Length (Ft.) <i>180'</i>
Type of Casing <i>PVC</i>	Hole Depth	Depth to Static Water Level

<b>LOG DATA</b>	
TYPE OF LOG RUN (Circle One): <input type="checkbox"/> No Log Run, <input type="checkbox"/> Electric, <input type="checkbox"/> Gamma Ray, <input type="checkbox"/> Density, <input type="checkbox"/> Sonic, <input type="checkbox"/> Neutron, Other (Describe) _____	
Name of Organization Running Log	

TYPE OF COMPLETION: (Circle One or More): <input checked="" type="checkbox"/> Gravel Packed, <input type="checkbox"/> Underreamed, <input type="checkbox"/> Telescoped, <input checked="" type="checkbox"/> Natural Development, <input type="checkbox"/> Open Hole, <input type="checkbox"/> Other (Describe) _____			
---	--	--	--

<b>GEOLOGIC DATA (Office Use Only)</b>			
Surface Elev.	Geologic Unit	Unit Thickness	Depth to Top
Subs. SWL	Date	Analysis	Aquifer Test

WELL GROUTED TO A DEPTH OF <i>10</i> FEET	
Type Grout (circle one) <input checked="" type="checkbox"/> Cement, <input type="checkbox"/> Bentonite, or Mix	

Driller's Remarks	
Top of Lap Pipe or Reduction in Casing	
FEET	IF TELESCOPED OR MORE THAN ONE SCREEN: USE BACK PAGE


<b>SCREEN DATA</b>		
Diameter - Inches <i>4"</i>	Length - Feet <i>20'</i>	Slot Size - Inches <i>8-10</i>
Screen Type <i>PVC</i>	Depth to Bottom - Feet	

DESCRIPTION OF FORMATIONS ENCOUNTERED	FROM	TO	FORMATIONS (Continued)	
			FROM	TO
<i>Sand</i>	<i>0</i>	<i>20</i>		
<i>clay</i>	<i>20</i>	<i>50</i>		
<i>clay</i>	<i>50</i>	<i>100</i>		
<i>Sand</i>	<i>100</i>	<i>200</i>		

**REC'D JUN 13 2001**

If well telescopes please  
sketch and show depths.

GROUND LEVEL

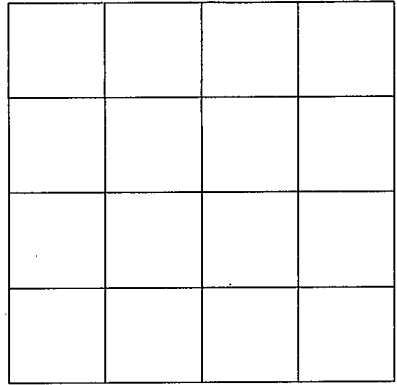

SECTION \_\_\_\_\_

Please indicate well location X.

ADDITIONAL INFORMATION

If more than one screen,  
show location of each on sketch.