

MISSISSIPPI DEPARTMENT OF ENVIRONMENTAL QUALITY
Office of Land and Water Resources

P. O. Box 10631
Jackson, MS 39289-0631
WATER WELL DRILLERS LOG

COUNTY WELL LOCATED
Linn
WELL NUMBER
319528
CODED

L-2237
DATE WELL COMPLETED
9-7-00

PERMIT NUMBER
510
NAME OF DRILLING FIRM
Easley Waterwell
B'haven MS 39601

NAME & MAILING ADDRESS OF LANDOWNER
Timothy Keys
350 Imperial Ln
Brookhaven MS 39601
WELL LOCATION: SEC _____ TOWNSHIP _____ RANGE _____
5 6 9 W
DISTANCE _____ MILES _____ OF _____
DIRECTION _____ NEAREST TOWN _____
OTHER LANDMARK _____
WELL PURPOSE: Home Irrigation, Municipal, Industrial, Fish Pond, etc.

PUMP DATA

PUMP TYPE (Circle One):
Submersible, Turbine, Jet, Flowing Well,
Other (Describe) _____
POWER TYPE (Circle One):
Electric, Tractor, Diesel, Gasoline, Butane,
Other (Describe) _____ H/P _____
Pump Capacity (GPM) _____ No. of Stages _____ Setting Depth _____ FT.
PUMP TEST
Well yielded _____ GPM with
a drawdown of _____ ft.
after _____ hours of pumping

WELL DATA

Well Depth 200 Casing Diameter (In.) 4" Casing Length (Ft.) 180'
Type of Casing PVC Hole Depth _____ Depth to Static Water Level _____
TYPE OF COMPLETION: (Circle One or More):
 Gravel Packed, Underreamed, Telescoped,
 Natural Development, Open Hole, Other _____
(Describe) _____

LOG DATA

TYPE OF LOG RUN (Circle One):
No Log Run, Electric, Gamma Ray, Density, Sonic, Neutron,
Other (Describe) _____
Name of Organization Running Log _____

WELL GROUTED TO A DEPTH OF 10 FEET
Type Grout (circle one): Cement, Bentonite, or Mix _____

GEOLOGIC DATA (Office Use Only)

Surface Elev.	Geologic Unit	Unit Thickness	Depth to Top
Subs. SWL	Date	Analysis	Aquifer Test

SCREEN DATA

Diameter - Inches 4" Length - Feet 20' Slot Size - Inches 0-10
Screen Type PVC Depth to Bottom - Feet _____

Driller's Remarks _____
Top of Lap Pipe or Reduction in Casing _____
FEET IF TELESCOPED OR MORE THAN ONE SCREEN: USE BACK PAGE


DESCRIPTION OF FORMATIONS ENCOUNTERED	FROM	TO
<u>Clay</u>	<u>0</u>	<u>10</u>
<u>Sand</u>	<u>10</u>	<u>25</u>
<u>Clay</u>	<u>25</u>	<u>180</u>
<u>Gravel</u>	<u>180</u>	<u>200</u>

FORMATIONS (Continued)	FROM	TO

REC'D JUN 13 2001

If well telescopes please
sketch and show depths.

GROUND LEVEL

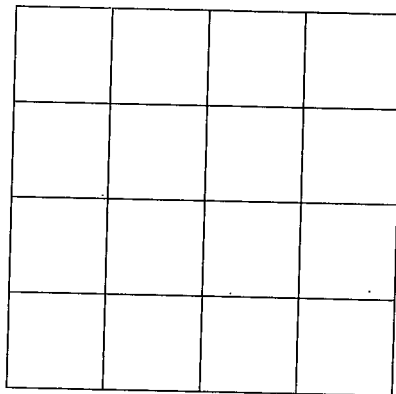

SECTION _____

Please indicate well location X.

ADDITIONAL INFORMATION

If more than one screen,
show location of each on sketch.