

Linn Co
M2 CODED
6-67

MISSISSIPPI
 BOARD OF WATER COMMISSIONERS
 416 North State Street
 Jackson, Mississippi 39201

WATER WELL DRILLERS LOG

June 1 19 *67* *Fitzgerald Water Well Service* *Linn Co*
 date well completed firm name county well located

LANDOWNER: *Lord Nations*
RT1 Bogue Phitta, Miss
 (mailing address)

description of formations encountered	from	to
<i>Red Clay</i>	<i>0</i>	<i>10</i>
<i>Red sand</i>	<i>10</i>	<i>15</i>
<i>Sand & gravel</i>	<i>25</i>	<i>81</i>

WELL LOCATION:
 sec. *36* T. *6* N. R. *8* E.
13 miles *SE* of *Brookhaven*
 (distance) (direction) (nearest town)

WELL PURPOSE: *home*
 (home, irrigation, municipal, industrial)

- WELL COMPLETION DATA:
- (1) diameter (inches) *4*
 - (2) total depth (feet) *81 ft*
 - (3) static water level (feet) *50* below above top of ground.
 - (4) casing *plastic* *75*
 (material) (depth)
4 if telescope see back.
 (size)
 - (5) screen *61* *75*
 (length) (depth to top)
4 *plastic*
 (size) (material)
 - (6) pump *HotJet* *10*
 (HP) (yield gpm)
3hp
 (type power)
 - (7) electric log *no*
 (yes or no)
 (organization running log)
 - (8) how well bottom plugged *Wood Peg*


CODED



DRILLERS REMARKS:

If well telescopes please sketch and show depths.

GROUND LEVEL

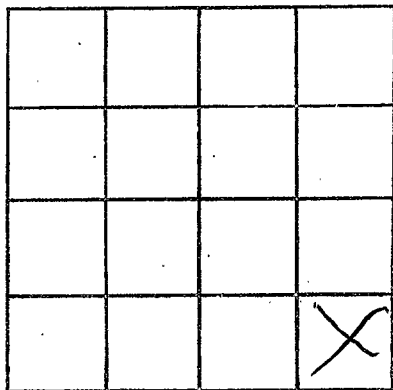

SECTION

86

Please indicate well location X.

ADDITIONAL INFORMATION

If more than one screen, show locations of each on sketch.