

Lincoln
 M3
 8-67 CODED

MISSISSIPPI
 BOARD OF WATER COMMISSIONERS
 416 North State Street
 Jackson, Mississippi 39201

WATER WELL DRILLERS LOG

Aug 10 1967 Reynolds & Kump Co. Lincoln
 date well completed firm name county well located

LANDOWNER: Reynolds
RFD
Brookhaven
 (mailing address)

WELL LOCATION:
 sec. 1 T. 6 N R. 8 E
8 miles SE of Brookhaven
 (distance) (direction) (nearest town)

WELL PURPOSE: Home
 (home, irrigation, municipal, industrial)


WELL COMPLETION DATA:

- (1) diameter (inches) 4"
- (2) total depth (feet) 109'
- (3) static water level (feet) 70 below top of ground.
- (4) casing Plastic Bottom
 (material) (depth)
- (size) if telescope see back.
- (5) screen 6' 103'
 (length) (depth to top)
4" Plastic
 (size) (material)
- (6) pump old pump
 (HP) (yield gpm)
split
 (type power)
- (7) electric log no
 (yes or no)
- (organization running log)
- (8) how well bottom plugged
wooden plug

DRILLERS REMARKS:
old well dry


description of formations encountered	from	to
Red clay	0	27
Red sand	27	60
sand & gravel	60	80
pink chalk	80	92
Coarse sand & gravel	92	109

CODED

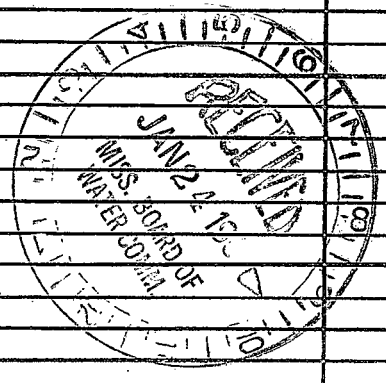

If well telescopes please
sketch and show depths.

GROUND LEVEL

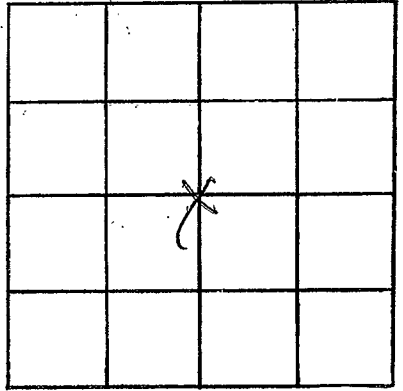

SECTION 1

Please indicate well location X.

ADDITIONAL INFORMATION

If more than one screen,
show locations of each on sketch.