

CODEN

MISSISSIPPI
BOARD OF WATER COMMISSIONERS
416 North State Street
Jackson, Mississippi 39201

WATER WELL DRILLERS LOG

Lincoln
M4
9-4-68

Sept 4 date well completed
68 Reeves well pumps firm name
Lincoln county well located

LANDOWNER: Marvin
Liven
RFD Brookhaven
(mailing address)

description of formations: encountered	from	to
Red clay	0	2.3
Red sandy sand	2.3	3.5
Red sand	3.5	7.0
Red gravel	7.0	7.5

WELL LOCATION:
sec 24 T 6 N R 8 E
5 1/2-6 miles NE Bogalusa
(distance) (direction) (nearest town)

WELL PURPOSE: Home
(home, irrigation, municipal, industrial)


WELL COMPLETION DATA:

- (1) diameter (inches) 4"
- (2) total depth (feet) 7.5
- (3) static water level: (feet) 40 below top of ground.
- (4) casing Plastic, Ballan (material) (depth)
- (size) if telescope see back.
- (5) screen 6' 6" (length) (depth to top)
4" Plastic (size) (material)
- (6) pump guener used and installed self pump (type power) elect
- (7) electric log NO (yes or no)

(organization running log)


(8) how well bottom plugged
wooden plug -

DRILLERS REMARKS:

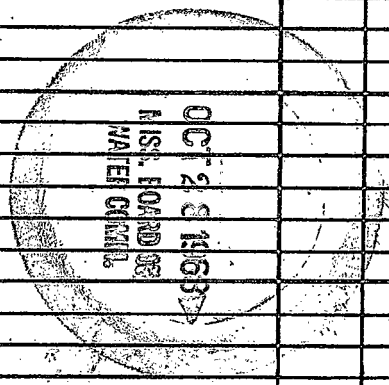

If well telescopes please sketch and show depths.

GROUND LEVEL

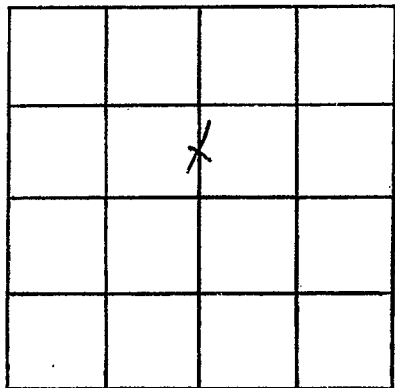

SECTION 24

Please indicate well location X.

ADDITIONAL INFORMATION

If more than one screen, show locations of each on sketch.