

CODED

Lincoln
M5
8-68

MISSISSIPPI
BOARD OF WATER COMMISSIONERS
416 North State Street
Jackson, Mississippi 39201

WATER WELL DRILLERS LOG

Aug 30 1968 Courtesy Home Lincoln
date/well completed firm name county well located

LANDOWNER: James G. ...
Brookhaven
(mailing address)


description of formations encountered	from	to
<u>U.D.</u>	<u>0</u>	<u>30</u>
<u>SAND & GRAVEL</u>	<u>30</u>	<u>58</u>

WELL LOCATION:
sec. 11 T. 6 N. R. 8 E.
9 miles S.E. of Brookhaven
(distance) (direction) (nearest town)

WELL PURPOSE: Home
(home, irrigation, municipal, industrial)


- WELL COMPLETION DATA:
- diameter (inches) 4"
 - total depth (feet) 58'
 - static water level (feet) 63' below above top of ground.
 - casing Plastic 82'
(material) (depth)
(size) If telescope see back.
 - screen 6" 82'
(length) (depth to top)
4" Plastic
(size) (material)
 - pump 1/2 6
(HP) (yield gpm)
A.C.
(type power)
 - electric log _____
(yes or no)
(organization running log)
 - how well bottom plugged wood

DRILLERS REMARKS:

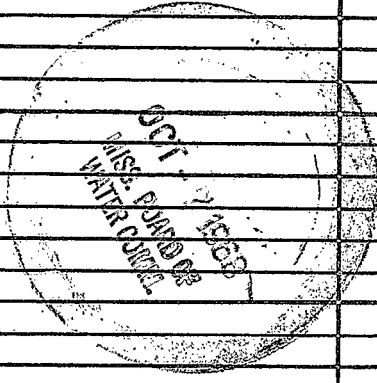

If well telescopes please sketch and show depths.

GROUND LEVEL

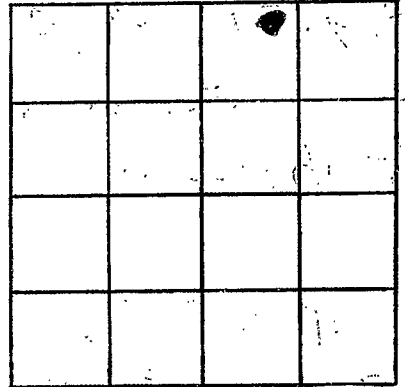

SECTION 11

Please indicate well location X.

ADDITIONAL INFORMATION

If more than one screen,
show locations of each on sketch.