

LINCOLN
M 6
9-9-69

MISSISSIPPI
BOARD OF WATER COMMISSIONERS
416 North State Street
Jackson, Mississippi 39201

CODED

WATER WELL DRILLERS LOG


Sept 9 1969 date well completed
Keenwell Pump Co - Lincoln firm name
Lincoln county well located

LANDOWNER:		description of formations encountered	from	to
(mailing address)				
Alexander Hall - Rt-4-Brookhaven		Red clay	0	22
WELL LOCATION:		Small peat gravel	22	55
sec 24 T 6 N R 8 E	7 mil E-NE	Rich chert gravel	55	70
(distance)	(direction)	Sea gravel band	70	76
(nearest town)				
WELL PURPOSE: Home (home, irrigation, municipal, industrial)				
WELL COMPLETION DATA:				
(1) diameter (inches) 4"				
(2) total depth (feet) 76				
(3) static water level (feet) 25 below top of ground				
(4) casing Plastic Bottom (material) (depth)				
(size) if telescope see back.				
(5) screen 6' 70' (length) (depth to top)				
14" Plastic (size) (material)				
(6) pump owned used (HP) (yield) gpm				
sed pump (type power)				
(7) electric log no (yes or no)				
(organization running log)				
(8) how well bottom plugged				
wooden plug				
DRILLERS REMARKS:				

SEP 29 1969
MISS. BD. OF WATER COMMISSIONERS

If well telescopes please sketch and show depths.

GROUND LEVEL

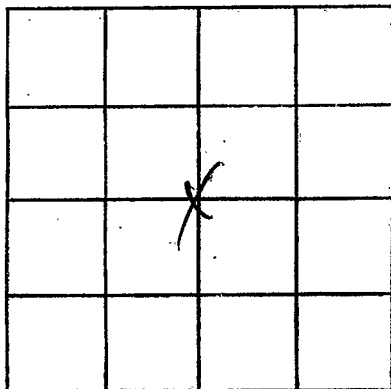

SECTION 24

Please indicate well location X.

ADDITIONAL INFORMATION

If more than one screen,
show locations of each on sketch.