

LINCOLN
M 8
3-10-71

MISSISSIPPI
BOARD OF WATER COMMISSIONERS
416 North State Street
Jackson, Mississippi 39201

CODED

WATER WELL DRILLERS LOG

10 March 1971 J.P. Watwell LINCOLN
date well completed firm name county well located

LANDOWNER:
Bill Cant
Bryth Miss.
(mailing address)

description of formations encountered	from	to
clay	0	25
chalk	25	100
sand	100	125
chalk	125	135
sand	135	100

WELL LOCATION:
sec 35 T 6 N R 8 E
S W
5 miles West of Bryth
(distance) (direction) (nearest town)

WELL PURPOSE:
(home, irrigation, municipal, industrial)

- WELL COMPLETION DATA:
- (1) diameter (inches) 4
 - (2) total depth (feet) 100
 - (3) static water level (feet) 80 below above top of ground.
 - (4) casing PI 100 (material) (depth) (size) if telescope see back.
 - (5) screen 6 100 (length) (depth to top) (size) PI (material)
 - (6) pump 1/2 9 (HP) (yield gpm) (type power) 9kw
 - (7) electric log (yes or no)
 - (organization running log)
 - (8) how well bottom plugged Wood

CODED


MAY 6 - 1971

DRILLERS REMARKS:

MISS. BD. OF
WATER COMM.

If well telescopes please sketch and show depths.

GROUND LEVEL

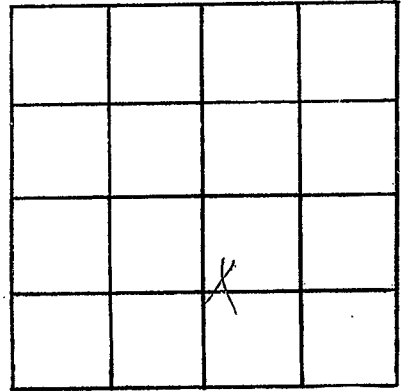

SECTION 35

Please indicate well location X.

ADDITIONAL INFORMATION

If more than one screen,
show locations of each on sketch.