

Lincoln
M10
2-8-72

MISSISSIPPI
 BOARD OF WATER COMMISSIONERS
 416 North State Street
 Jackson, Mississippi 39201

WATER WELL DRILLERS LOG **CODED**

Feb. 8 19 72 Green Water Well Contr. Lincoln
 date well completed firm name county well located

LANDOWNER: <u>Arnold Sutton</u> <u>Route 2</u> <u>Bogue Chitto, Miss.</u> (mailing address)	description of formations encountered	from	to
	<u>Red sand</u>	<u>0</u>	<u>50</u>
	<u>Clay sand</u>	<u>50</u> <u>160</u>	<u>160</u> <u>240</u>

WELL LOCATION:
 sec. 7 T. 6 N. R. 8 E
 S. W.
6 miles S of Brookhaven
 (distance) (direction) (nearest town)

WELL PURPOSE: home
 (home, irrigation, municipal, industrial)

- WELL COMPLETION DATA:
- diameter (inches) 6
 - total depth (feet) 240
 - static water level (feet) 50 below above top of ground.
 - casing PVC, 210,
 (material) (depth)
4"
 (size) if telescope see back.
 - screen 6', 210
 (length) (depth to top)
.010 PVC
 (size) (material)
 - pump 1/2 Sub., 7
 (HP) (yield gpm)
electric
 (type power)
 - electric log no
 (yes or no)
 (organization running log)
 - how well bottom plugged wood

CODED


APR 25 1972

MISS. BU.
 WATER CON.

DRILLERS REMARKS:

If well telescopes please sketch and show depths.

GROUND LEVEL

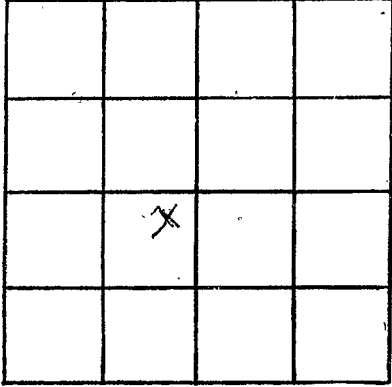

SECTION 7

Please indicate well location X.

ADDITIONAL INFORMATION

If more than one screen, show locations of each on sketch.