

LINCOLN
M12
5-18-72

MISSISSIPPI
 BOARD OF WATER COMMISSIONERS
 416 North State Street
 Jackson, Mississippi 39201

CODED

WATER WELL DRILLERS LOG

18 Mar 19 72 S of Water Well Lincoln
 date well completed firm name county well located

LANDOWNER:
Bernie Greer
Frank Smith
 (mailing address)

description of formations encountered	from	to
<u>Clay</u>	<u>0</u>	<u>20</u>
<u>Sand Shale</u>	<u>20</u>	<u>45</u>
<u>Gravel</u>	<u>45</u>	<u>70</u>

WELL LOCATION:
 sec. 35 T 6 N R 8 E
 (distance) miles (direction) of (nearest town)

WELL PURPOSE:
 (home, irrigation, municipal, industrial)

- WELL COMPLETION DATA:
- (1) diameter (inches) 4
 - (2) total depth (feet) 75
 - (3) static water level (feet) 50 below above top of ground.
 - (4) casing 11 / 69
 (material) (depth)
 (size) if telescope see back.
 - (5) screen 6 / 69
 (length) (depth to top)
4 / 11
 (size) (material)
 - (6) pump 1/2 / 8
 (HP) (yield gpm)
Electric
 (type power)
 - (7) electric log (yes or no) _____
 (organization running log) _____
 - (8) how well bottom plugged wood

CODED

JUL 25 1972


DRILLERS REMARKS: _____

MISS. BD. OF
 WATER COMMISSIONERS

If well telescopes please sketch and show depths.

Handwritten notes or scribbles

GROUND LEVEL

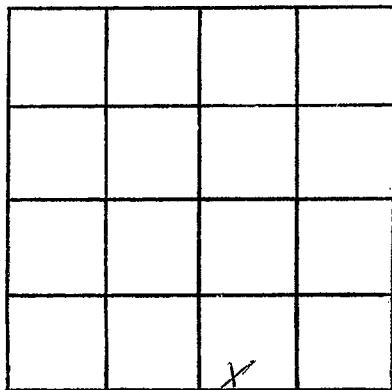

SECTION 37

Please indicate well location X.

ADDITIONAL INFORMATION

A series of horizontal lines for writing additional information.

If more than one screen, show locations of each on sketch.