

LINCOLN
M13
7-26-72

MISSISSIPPI
 BOARD OF WATER COMMISSIONERS
 416 North State Street
 Jackson, Mississippi 39201

WATER WELL DRILLERS LOG

CODED

July 26 19 72 Green Water Well Cont. Lincoln
 date well completed firm name county well located

LANDOWNER: <u>Walter Jergens</u>	description of formations encountered	from	to
<u>Route 2</u>	<u>Clay sand + gravel</u>	<u>0</u>	<u>115</u>
<u>Bogue Chitto Mine</u> (mailing address)	<u>clay</u>	<u>115</u>	<u>130</u>
WELL LOCATION:			
sec <u>36</u> T <u>6</u> N R <u>8</u> E			
<u>10</u> miles <u>SE</u> of <u>Brookhaven</u> (distance) (direction) (nearest town)			
WELL PURPOSE: <u>home</u> (home, irrigation, municipal, industrial)			
WELL COMPLETION DATA:			
(1) diameter (inches) <u>6"</u>			
(2) total depth (feet) <u>130</u>			
(3) static water level (feet) <u>70</u> below top of ground.			
(4) casing <u>PVC</u> , <u>100</u> (material) (depth)			
<u>4'</u> if telescope see back. (size)			
(5) screen <u>6"</u> , <u>100</u> (length) (depth to top)			
<u>010</u> , <u>PVC</u> (size) (material)			
(6) pump <u>1/3 hp</u> , <u>7</u> (HP) (yield gpm)			
<u>Electric</u> (type power)			
(7) electric log <u>no</u> (yes or no)			
(organization running log)			
(8) how well bottom plugged <u>good</u>			
DRILLERS REMARKS:			


CODED

SEP 27 1972

MISS. BU. OF
 WATER RESOURCES

If well telescopes please sketch and show depths.

GROUND LEVEL

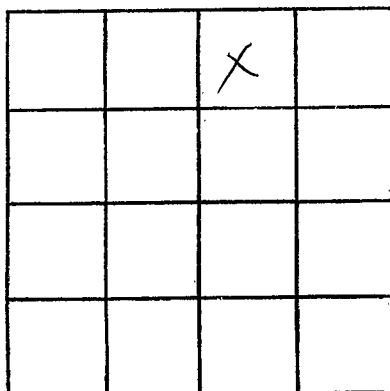

SECTION 36

Please indicate well location X.

ADDITIONAL INFORMATION

If more than one screen,
show locations of each on sketch.