

LINCOLN
M 16
4-10-73

MISSISSIPPI
 BOARD OF WATER COMMISSIONERS
 416 North State Street
 Jackson, Mississippi 39201

CODED

WATER WELL DRILLERS LOG

4-10 1973 Green Water Well Co. Lincoln
 date well completed firm name county well located

LANDOWNER: Earl Wallace
Rt 2
Bogue Chitto
 (mailing address)

description of formations encountered
Citrouille
 from 0 to 80

WELL LOCATION:
 sec. 11 T. 6 N R. 8 E
5 miles S of Broadway
 (distance) (direction) (nearest town)

WELL PURPOSE: home
 (home, irrigation, municipal, industrial)

WELL COMPLETION DATA:
 (1) diameter (inches) 6"
 (2) total depth (feet) 80
 (3) static water level (feet) 53 below top of ground.
 (4) casing PVC, 64'
 (material) (depth)
 (size) if telescope see back.
 (5) screen 6' 64'
 (length) (depth to top)
0.10 PVC
 (size) (material)
 (6) pump 1/2 sub 7
 (HP) (yield gpm)
electric
 (type power)
 (7) electric log no
 (yes or no)
 (organization running log)
 (8) how well bottom plugged wood


CODED

DRILLERS REMARKS:

MAY 23 1973

If well telescopes please
sketch and show depths.

GROUND LEVEL

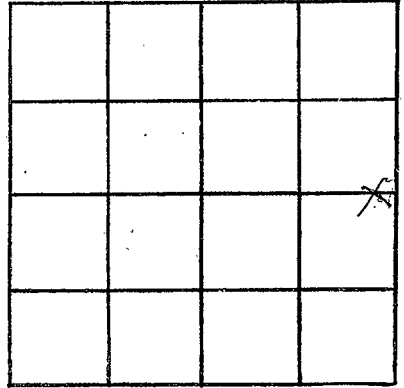

SECTION 11

Please indicate well location X.

ADDITIONAL INFORMATION

If more than one screen,
show locations of each on sketch.