

LINCOLN
MI
5-28-74

MISSISSIPPI
 BOARD OF WATER COMMISSIONERS
 416 North State Street
 Jackson, Mississippi 39201

CODED

WATER WELL DRILLERS LOG

May 28 1974 Grenn Water Well Cont. Lincoln
 date well completed firm name county well located

LANDOWNER: Bill Wooley
P.O. Box 479
Brookhaven, Miss.
 (mailing address)

description of formations encountered
Citronelle
 from 0 to 70

WELL LOCATION:
 sec. 21 T. 6 R. 8
7 miles SE of Brookhaven
 (distance) (direction) (nearest town)

CODED


WELL PURPOSE: home
 (home, irrigation, municipal, industrial)

- WELL COMPLETION DATA:
- (1) diameter (inches) 6"
 - (2) total depth (feet) 70
 - (3) static water level (feet) 50 below above top of ground.
 - (4) casing PVC 64
 (material) (depth)
4" if telescope see back.
 (size)
 - (5) screen 6" 64
 (length) (depth to top)
.010 PVC
 (size) (material)
 - (6) pump did not install
 (HP) (yield gpm)
 - (type power)
 - (7) electric log no
 (yes or no)
 - (organization running log)
 - (8) how well bottom plugged wood

DRILLERS REMARKS:
 RECEIVED
 MAY 27 1974
 MISS. BD. OF WATER

If well telescopes please sketch and show depths.

GROUND LEVEL

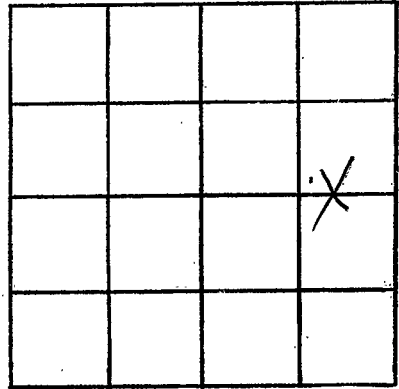

SECTION 21

Please indicate well location X.

ADDITIONAL INFORMATION

If more than one screen,
show locations of each on sketch.