

LINCOLN  
M 18  
5-27-74

MISSISSIPPI BOARD OF WATER COMMISSIONERS CODED  
416 North State Street  
Jackson, Mississippi 39201

WATER WELL DRILLERS LOG

May 27 1974 Grenn Water Well Cont. Lincoln  
date well completed firm name county well located


LANDOWNER:	description of formations encountered	from	to
George Earls Rt. 2, Box 234 Bogue Chitto, Miss. (mailing address)	Citronelle	0	96
WELL LOCATION: sec. 26 T 6 N R 8 E 7 miles SE of Brookhaven (distance) (direction) (nearest town)	CODED		
WELL PURPOSE: home (home, irrigation, municipal, industrial)			
WELL COMPLETION DATA:			
(1) diameter (inches) 6"			
(2) total depth (feet) 96			
(3) static water level (feet) 50 below top of ground.			
(4) casing PVC, 90 (material) (depth) 4" (size) if telescope see back.			
(5) screen 6' 90 (length) (depth to top) 0.10 PVC (size) (material)			
(6) pump 1/3 sub 7 (HP) (yield gpm) electric (type power)			
(7) electric log no (yes or no) (organization running log)			
(8) how well bottom plugged wood			
DRILLERS REMARKS:			

RECEIVED  
MAY 27 1974

MISS. BD. OF WATER COMM.

If well telescopes please sketch and show depths.

GROUND LEVEL

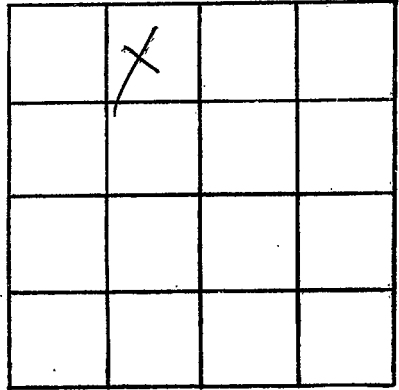

SECTION 26

Please indicate well location X.

ADDITIONAL INFORMATION

If more than one screen,  
show locations of each on sketch.