

Lincoln
M21
9-12-74

MISSISSIPPI
BOARD OF WATER COMMISSIONERS
416 North State Street
Jackson, Mississippi 39201

CODED

WATER WELL DRILLERS LOG

Sept. 12 1974 Green Water Well Lincoln
date well completed firm name county well located


LANDOWNER:	description of formations encountered	from	to
Zeb Wayne McGrew Route 2, Bogue Chitto, Ms. (mailing address)	Citronelle	0	106
WELL LOCATION: sec. 36 T. 6 N. R. 8 E. 8 SE of Brookhaven (distance) (direction) (nearest town)			
WELL PURPOSE: home (home, irrigation, municipal, industrial)			
WELL COMPLETION DATA:			
(1) diameter (inches) 6			
(2) total depth (feet) 106			
(3) static water level (feet) 60 below top of ground.			
(4) casing PVC, 100 (material) (depth) 4" (size) if telescope see back.			
(5) screen 6' (length), 100 (depth to top) .010 PVC (size) (material)			
(6) pump 1/3 HP (HP), 7 (yield gpm) electric (type power)			
(7) electric log no (yes or no) (organization running log)			
(8) how well bottom plugged wood			

GREENVIEW
OCT 25 1974

DRILLERS REMARKS:

If well telescopes please sketch and show depths.

GROUND LEVEL

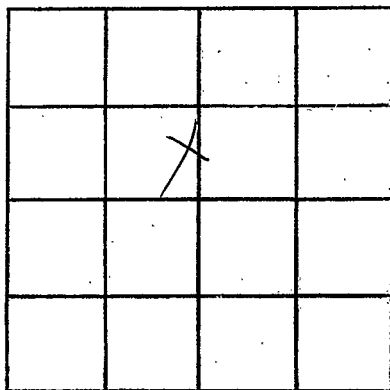

SECTION 36

Please indicate well location X.

ADDITIONAL INFORMATION

If more than one screen, show locations of each on sketch.