

Lincoln
M 22
9-5-74

MISSISSIPPI
 BOARD OF WATER COMMISSIONERS
 416 North State Street
 Jackson, Mississippi 39201


WATER WELL DRILLERS LOG

Sept. 5 1974 Grenn Water Well Lincoln **CODED**
 date well completed firm name county well located

LANDOWNER:	description of formations encountered	from	to
Mike Smith			
Rt. 4, Brookhaven, Miss. (mailing address)			
WELL LOCATION:			
sec <u>22</u> T <u>6</u> N R <u>8</u> E <small> x x</small>			
<u>7</u> miles <u>SE</u> of <u>Brookhaven</u> <small>(distance) (direction) (nearest town)</small>			
WELL PURPOSE: <u>home</u> <small>(home, irrigation, municipal, industrial)</small>			
WELL COMPLETION DATA:			
(1) diameter (inches) <u>6"</u>			
(2) total depth (feet) <u>51</u>			
(3) static water level (feet) <u>30</u> <small>below</small> above <small>top of ground.</small>			
(4) casing <u>PVC</u> , <u>45</u> <small>(material) (depth)</small> <u>4"</u> if telescope see back. <small>(size)</small>			
(5) screen <u>6'</u> , <u>45</u> <small>(length) (depth to top)</small> <u>.010</u> , <u>PVC</u> <small>(size) (material)</small>			
(6) pump <u>did not install</u> <small>(HP) (yield gpm)</small> <small>(type power)</small>			
(7) electric log <u>no</u> <small>(yes or no)</small> <small>(organization running log)</small>			
(8) how well bottom plugged <u>wood</u>			
DRILLERS REMARKS:			
<p style="text-align: center;">RECEIVED 12/5 1974 OCT 25 1974</p>			
MISS. BD. OF WATER COMMISSIONERS			

If well telescopes please sketch and show depths.

GROUND LEVEL

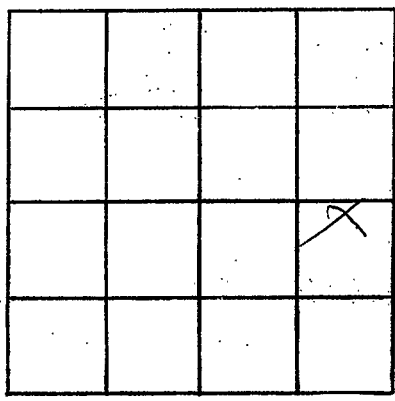

SECTION *22*

Please indicate well location. X.

ADDITIONAL INFORMATION

A series of horizontal lines for writing additional information, starting below the 'ADDITIONAL INFORMATION' header and extending to the bottom of the page.

If more than one screen, show locations of each on sketch.