

LINCOLN
M 24
8-2-74

MISSISSIPPI
BOARD OF WATER COMMISSIONERS
416 North State Street
Jackson, Mississippi 39201

CODED

WATER WELL DRILLERS LOG

Aug 2 19 74 date well completed
Chester Reeves firm name
Lincoln county well located

LANDOWNER: Larry Hall -
RFD Ruth -
(mailing address)

WELL LOCATION:
sec. 24 T 6 N R 8 E
7 miles N-NW of Ruth
(distance) (direction) (nearest town)

WELL PURPOSE: Home -
(home, irrigation, municipal, industrial)

- WELL COMPLETION DATA:
- (1) diameter (inches) 4"
 - (2) total depth (feet) 80
 - (3) static water level (feet) 30 below top of ground.
 - (4) casing Plast. Bottom (material) (depth)
 - (5) screen 6' 74' (length) (depth to top)
1/2" Plast (size) (material)
 - (6) pump By owner (type power) (yield gpm)
 - (7) electric log No (yes or no)
 - (8) how well bottom plugged Woodchips

DRILLERS REMARKS:
New location


description of formations encountered	from	to
clay	0	14
cherty sand	14	30
sand & gravel	30	58
colored chalk	58	72
CODED	72	80

RECEIVED
FEB 28 1975

MISS. Bd. OF WATER COMM

If well telescopes please sketch and show depths.

GROUND LEVEL

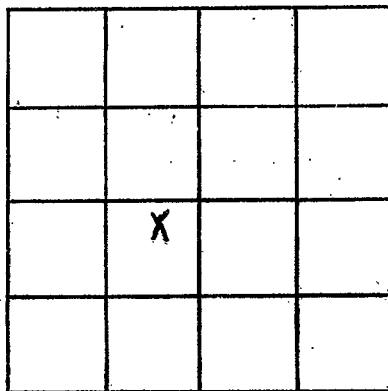

SECTION 24

Please indicate well location X.

ADDITIONAL INFORMATION

If more than one screen, show locations of each on sketch.