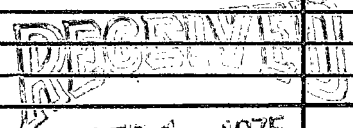


Lincoln  
M 25  
5-17-75


MISSISSIPPI  
 BOARD OF WATER COMMISSIONERS  
 416 North State Street  
 Jackson, Mississippi 39201  
**WATER WELL DRILLERS LOG**

May 17 1975 Grenn Water Well Cont. Lincoln  
 date well completed firm name county well located

LANDOWNER: <u>B. E. Rutledge</u>	description of formations encountered	from	to
Route 2			
<u>Bogue Chitto, Miss.</u> (mailing address)	Clay	1	5
	Sand & gravel	5	39
	White clay?	39	55
	Blue Clay?	55	209
	Sand	209	232
<b>WELL LOCATION:</b>			
sec. <u>30</u> T. <u>6</u> <u>N</u> R. <u>8</u> <u>E</u> <u>134</u>			
<u>9</u> miles <u>S</u> of <u>Brookhaven</u>			
(distance) (direction) (nearest town)			
<b>WELL PURPOSE:</b> <u>home</u> (home, irrigation, municipal, industrial)			
<b>WELL COMPLETION DATA:</b>			
(1) diameter (inches) <u>6"</u>			
(2) total depth (feet) <u>232</u>			
(3) static water level (feet) <u>40</u> below top of ground.			
(4) casing <u>PVC</u> <u>220</u> (material) (depth)			
<u>4"</u> if telescope see back. (size)			
(5) screen <u>12'</u> <u>220'</u> (length) (depth to top)			
<u>.010</u> <u>PVC</u> (size) (material)			
(6) pump <u>1/3</u> sub <u>7</u> (HP) (yield gpm)			
<u>electric</u> (type power)			
(7) electric log <u>no</u> (yes or no)			
(organization running log)			
(8) how well bottom plugged <u>wodd</u>			
<b>DRILLERS REMARKS:</b>			
 SEP 16 1975 MISS. Bd. OF WATER COMMISSIONERS			

If well telescopes please sketch and show depths.

GROUND LEVEL

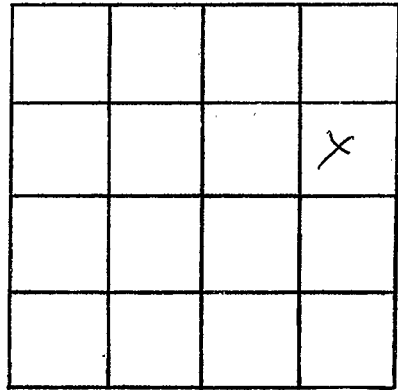

SECTION 50

Please indicate well location X.

ADDITIONAL INFORMATION

If more than one screen,  
show locations of each on sketch.