

MISSISSIPPI DEPARTMENT OF NATURAL RESOURCES

Bureau of Land and Water Resources

Southport Mall

P.O. Box 10631

Jackson, Mississippi 39209

WATER WELL DRILLERS LOG

COPY

Lincoln

M26

Jan. 19 19 82 Gretn Water Well Cont. Lincoln
 date well completed firm name county well located

LANDOWNER: Harold McClella	Description of formations encountered	from	to
Route 29	clay	1	20
Bogue Chitto, Ms.	sand & gravel	20	43
(mailing address)	white clay	43	60
WELL LOCATION:	Blue clay	60	180
sec. <u>18</u> <u>6</u> N R <u>8</u> E	white clay	180	200
S W	sand	200	250
<u>4</u> miles N of Bogue Chitto			
(distance) (direction) (nearest town)			
WELL PURPOSE: <u>home</u>			
(home, irrigation, municipal, industrial)			
WELL COMPLETION DATA:			
(1) diameter (inches) <u>4</u>			
(2) total depth (feet) <u>250</u>			
(3) static water level (feet) <u>48</u> below above top of ground.			
(4) casing <u>PVC</u> <u>240</u>			
(material) (depth)			
<u>4"</u> (size) if telescope see back.			
(5) screen <u>10'</u> <u>240'</u>			
(length) (depth to top)			
<u>.010</u> <u>PVC</u>			
(size) (material)			
(6) pump <u>1/2</u> sub <u>8</u>			
(HP) (yield gpm)			
<u>electricity</u>			
(type power)			
(7) electric log <u>no</u>			
(yes or no)			
(organization running log)			
(8) how well bottom plugged back wash valve			
DRILLERS REMARKS:			


DEPT. OF NATURAL RESOURCES
 BUREAU OF LAND & WATER RESOURCES

FEB 11 1982

RECEIVED

If well telescopes please sketch and show depths.

GROUND LEVEL

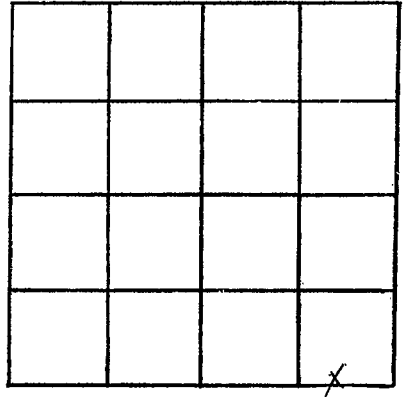

SECTION 18

Please indicate well location X.

ADDITIONAL INFORMATION

If more than one screen, show locations of each on sketch.