

MISSISSIPPI DEPARTMENT OF NATURAL RESOURCES

Bureau of Land and Water Resources

Southport Mall

P.O. Box 10631

Jackson, Mississippi 39209

WATER WELL DRILLERS LOG

LINCOLN  
M 29  
3/31/83

3-31-83

Griner Drilling Service, Inc.

Lincoln

date well completed

firm name

county well located

LANDOWNER:

Shell Oil Company  
P.O. Box 61555  
New Orleans, La 70160  
(mailing address)

description of formations encountered

from

to

top clay

0 10

gravel

10 58

clay

58 123

sand, pea gravel

123 199

clay

199 221

WELL LOCATION: 660'N + 1780'E

sec. 8 T 6N R 8 E S 1/4

no. 1 West  
West (direction) (nearest town)  
Madison 2-14

WELL PURPOSE: oil field supply  
(home, irrigation, municipal, industrial)

WELL COMPLETION DATA:

(1) diameter (inches) 4"

(2) total depth (feet) 221'

(3) static water level (feet) 30' below top of ground.

(4) casing steel, 189' (material) (depth)

4" (size) if telescope see back.

(5) screen 42' 147' (length) (depth to top)

4" perforated (size) (material)

(6) pump 95 (HP) (yield gpm)

AC (type power)

(7) electric log (yes or no)

(organization running log)

(8) how well bottom plugged orange

peel

DRILLERS REMARKS:

CODED


DEPT. OF NATURAL RESOURCES  
BUREAU OF LAND & WATER RESOURCES

APR 20 1983

RECEIVED

If well telescopes please sketch and show depths.

GROUND LEVEL

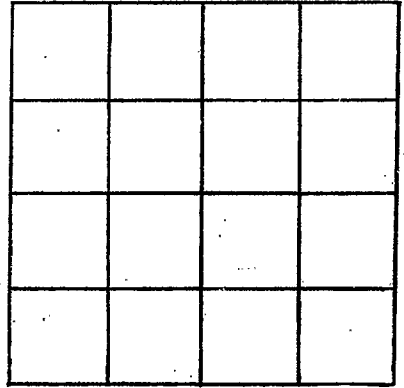

SECTION \_\_\_\_\_

Please indicate well location X.

ADDITIONAL INFORMATION

If more than one screen,  
show locations of each on sketch.