

MISSISSIPPI DEPARTMENT OF NATURAL RESOURCES

Bureau of Land and Water Resources

Southport Mall

P.O. Box 10631

Jackson, Mississippi 39209

CODED

WATER WELL DRILLERS LOG

Griner Drilling Service, Inc.

Lincoln

LINCOLN
M30
2/2/83

2-2-83
date well completed

Griner Drilling Service, Inc.
firm name

Lincoln
county well located

LANDOWNER:	description of formations encountered	from	to
Shell Oil Company P.O. Box 61555 New Orleans, La. 70160 (mailing address)	sand, pea gravel	0	70
	Clay	70	160
WELL LOCATION: 600' N + 1780' E sec. 8 T. 6 N R. 8 E SW 1/4 West Mallieco (distance) miles (direction) (nearest town)	sand, pea gravel	160	230
	Clay	230	252
WELL PURPOSE: oilfield supply (home, irrigation, municipal, industrial)			
WELL COMPLETION DATA:			
(1) diameter (inches) 4"			
(2) total depth (feet) 252'			
(3) static water level (feet) 40' below top of ground.			
(4) casing steel 231' (material) (depth); 4" (size) if telescope see back.			
(5) screen 42' 189' (length) (depth to top); 4" perforated (size) (material)			
(6) pump — 80 (HP) (yield gpm); AC (type power)			
(7) electric log — (yes or no)			
(8) how well bottom plugged peel Orange			

CODED

DEPT. OF NATURAL RESOURCES
BUREAU OF LAND & WATER RESOURCES


AUG 4 1983

RECEIVED

DRILLERS REMARKS:

If well telescopes please sketch and show depths.

GROUND LEVEL

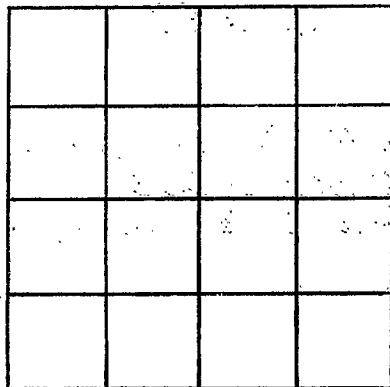

SECTION _____

Please indicate well location X.

ADDITIONAL INFORMATION

If more than one screen, show locations of each on sketch.