

MISSISSIPPI DEPARTMENT OF NATURAL RESOURCES

Bureau of Land and Water Resources

Southport Mall

P.O. Box 10631

CODING

Jackson, Mississippi 39209

WATER WELL DRILLERS LOG

Griner Drilling Service, Inc.

Lincoln

M31
Lincoln Co.
11-2-83

11-2-83 date well completed Griner Drilling Service, Inc. firm name Lincoln county well located

LANDOWNER:	description of formations encountered	from	to
Shell Oil Co. P.O. Box 60193 New Orleans, La 70160 (mailing address)	chalk, rock	10	105
WELL LOCATION: 1320' N + 2530' W sec. 8 T 6 N R 8 E SE 101 No. 8-15B Mallalieu Field (distance) (direction) (nearest town)	sand	105	189
WELL PURPOSE: oil field supply (home, irrigation, municipal, industrial)	chalk, rock	189	231
WELL COMPLETION DATA:			
(1) diameter (inches) 4"			
(2) total depth (feet) 231'			
(3) static water level (feet) 6' below top of ground.			
(4) casing steel 168' (material), (depth) 4" (size) if telescope see back.			
(5) screen 42' 126' (length), (depth to top) 4" perforated (size), (material)			
(6) pump — 70 (HP), (yield gpm) AC (type power)			
(7) electric log — (yes or no) (organization running log)			
(8) how well bottom plugged orange peat			
DRILLERS REMARKS:			

SWS 1/4, SE 1/4


DEPT. OF NATURAL RESOURCES
BUREAU OF LAND & WATER RESOURCES

NOV 29 1983

RECEIVED

If well telescopes please sketch and show depths.

GROUND LEVEL

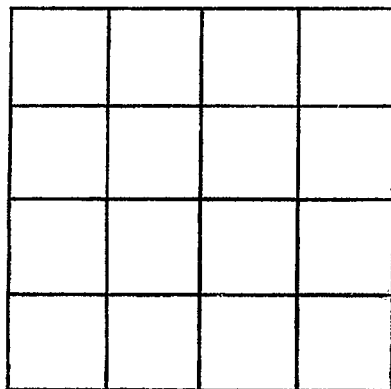

SECTION _____

Please indicate well location X.

ADDITIONAL INFORMATION

If more than one screen, show locations of each on sketch.