

MISSISSIPPI DEPARTMENT OF NATURAL RESOURCES

Bureau of Land and Water Resources

Southport Mall

P.O. Box 10631

Jackson, Mississippi 39209

CODED

WATER WELL DRILLERS LOG

Griner Drilling Service, Inc.

Lincoln

Lincoln
M 32
2-24-84

2-24-84
date well completed

Griner Drilling Service, Inc.
firm name

Lincoln
county well located

LANDOWNER:

Helmerich and Payne
P.O. Box 6173
Pearl, Ms. 39208
(mailing address)

description of formations encountered

from

to

WELL LOCATION: 2640' N 42640' W

No. sec. 18 T 6 S R 8 E of 18-10
West Mallett Unit
(distance) miles (direction) of (nearest town)

fill-sand, gravel	0	15
clay	15	105
streaked, mostly sand	105	150
sand, pea gravel	150	209
CLAY	209	214

WELL PURPOSE: oil field supply
(home, irrigation, municipal, industrial)

WELL COMPLETION DATA:

- (1) diameter (inches) 4"
- (2) total depth (feet) 214'
- (3) static water level (feet) 10' ^{below} _{above} top of ground.
- (4) casing Steel, 210'
(material) (depth)
4"
(size) if telescope see back.
- (5) screen 42', 168'
(length) (depth to top)
4", perforated
(size) (material)
- (6) pump —, 80-90
(HP) (yield gpm)
AC
(type power)
- (7) electric log —
(yes or no)
—
(organization running log)
- (8) how well bottom plugged orange peel


DRILLERS REMARKS:

MISSISSIPPI DEPARTMENT OF NATURAL RESOURCES
BUREAU OF LAND & WATER RESOURCES

RECEIVED
MAR - 6 1984

If well telescopes please sketch and show depths.

GROUND LEVEL

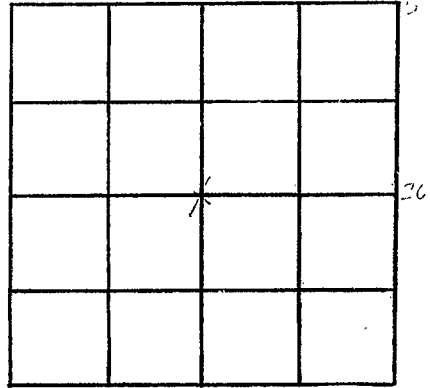

SECTION _____

Please indicate well location X.

ADDITIONAL INFORMATION

If more than one screen,
show locations of each on sketch.