

MISSISSIPPI DEPARTMENT OF NATURAL RESOURCES

Bureau of Land and Water Resources

Southport Mall

P.O. Box 10631

Jackson, Mississippi 39209

WATER WELL DRILLERS LOG

CODED

LINCOLN
M 33

Griner Drilling Service, Inc.

Lincoln

9-21-84
date well completed

firm name

county well located

LANDOWNER:	description of formations encountered	from	to
See Land Drilling 900 Dunn Street Houma, La. (mailing address)	clay, sand	0	126
WELL LOCATION: 500' N + 330' E sec. 19 T 60 N R 8 E SW 10 No. 1 T. Brady et al. 13 miles of (distance) (direction) (nearest town)	sand	126	147
WELL PURPOSE: oilfield supply (home, irrigation, municipal, industrial)	sand, pea gravel	147	210
WELL COMPLETION DATA: (1) diameter (inches) 3" (2) total depth (feet) 252' (3) static water level (feet) 20' below top of ground. (4) casing steel, 210' (material) (depth) 3" if telescope see back. (size) (5) screen 42' 168' (length) (depth to top) 3" perforated (size) (material) (6) pump - 90 (HP) (yield gpm) AC (type power) (7) electric log (yes or no) (organization running log) (8) how well bottom plugged orange pee	clay, sand	210	252
DRILLERS REMARKS:			

CODED


DEPT. OF NATURAL RESOURCES
BUREAU OF LAND & WATER RESOURCES

SEP 28 1984

RECEIVED

If well telescopes please sketch and show depths.

GROUND LEVEL

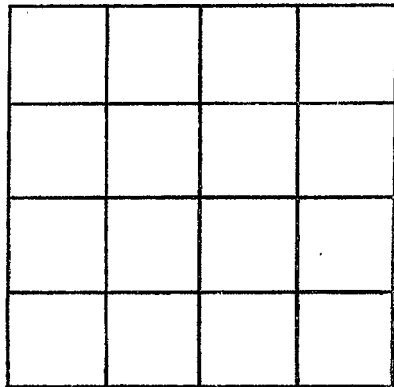

SECTION _____

Please indicate well location X.

ADDITIONAL INFORMATION

If more than one screen,
show locations of each on sketch.