

LINCOLN

M 35

MISSISSIPPI DEPARTMENT OF NATURAL RESOURCES
 Bureau of Land and Water Resources
 Southport Mall
 P.O. Box 10631
 Jackson, Mississippi 39209
WATER WELL DRILLERS LOG

CODED

11-9 84 Grenn Water Well Lincoln
 date well completed firm name county well located

LANDOWNER: Greg Grice

description of formations encountered	from	to
Citronelle	1	97

P.O. Box 87

Brookhaven, Ms.
(mailing address)

WELL LOCATION:

sec. 26 T 6 N R 8 E
 S W
 4 miles NE of Bogue Chitto
 (distance) (direction) (nearest town)

CODED

WELL PURPOSE: home
(home, irrigation, municipal, industrial)

WELL COMPLETION DATA:

- (1) diameter (inches) 4
- (2) total depth (feet) 97
- (3) static water level (feet) 21 below top of ground.
- (4) casing PVC, 87' (material) (depth)
 4" (size) if telescope see back.
- (5) screen 10' (length), 87' (depth to top)
 .010 (size), PVC (material)
- (6) pump did not install (HP) (yield gpm)
 (type power)
- (7) electric log no (yes or no)
 (organization running log)
- (8) how well bottom plugged back wash valve


RECEIVED
 APR 17 1985

Department of Natural Resources
 Bureau of Land & Water Resources

DRILLERS REMARKS:

If well telescopes please sketch and show depths.

GROUND LEVEL

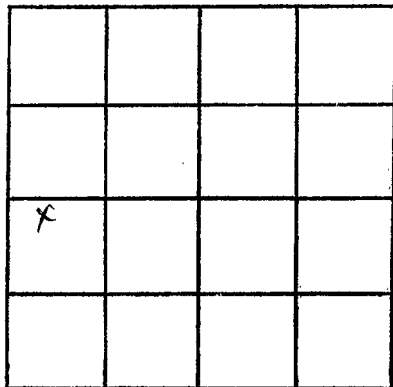

SECTION 26

Please indicate well location X.

ADDITIONAL INFORMATION

If more than one screen,
show locations of each on sketch.