

LINCOLN
M 36
4-11-85

MISSISSIPPI DEPARTMENT OF NATURAL RESOURCES
Bureau of Land and Water Resources
Southport Mall
P.O. Box 10631
Jackson, Mississippi 39209
WATER WELL DRILLERS LOG

April 11 1985 Grenn Water Well Lincoln
date well completed firm name county well located


LANDOWNER: Jerry Orr P.O. Box 255 Brookhaven, Ms. (mailing address)	description of formations encountered Citronelle	from 1	to 72
WELL LOCATION: sec. <u>5</u> T. <u>6</u> (N) R. <u>8</u> (E) <u>3</u> miles South of Brookhaven (distance) (direction) (nearest town)			
WELL PURPOSE: home (home, irrigation, municipal, industrial)			
WELL COMPLETION DATA:			
(1) diameter (inches) <u>4</u>			
(2) total depth (feet) <u>72</u>			
(3) static water level (feet) <u>46</u> below above top of ground.			
(4) casing <u>PVC</u> <u>62'</u> (material) (depth) <u>4"</u> (size) if telescope see back.			
(5) screen <u>10'</u> <u>62'</u> (length) (depth to top) <u>.010</u> <u>PVC</u> (size) (material)			
(6) pump <u>1/2</u> sub <u>8</u> (HP) (yield gpm) <u>electricity</u> (type power)			
(7) electric log <u>no</u> (yes or no) <u>(organization running log)</u>			
(8) how well bottom plugged <u>back wash valve</u>			
DRILLERS REMARKS:			

RECEIVED
MAY 17 1985

Department of Natural Resources
Bureau of Land & Water Resources

If well telescopes please sketch and show depths.

GROUND LEVEL

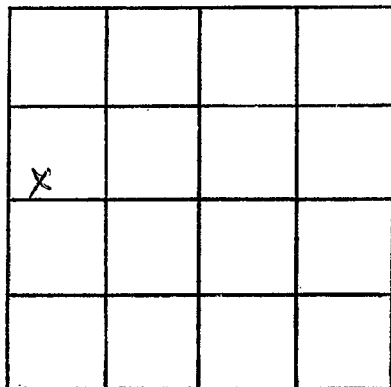

SECTION 5

Please indicate well location X.

ADDITIONAL INFORMATION

If more than one screen,
show locations of each on sketch.