

MISSISSIPPI DEPARTMENT OF NATURAL RESOURCES
Bureau of Land and Water Resources
 Southport Mall
 P.O. Box 10631
 Jackson, Mississippi 39209
WATER WELL DRILLERS LOG

CODED⁸⁵

Lincoln
M 37
10-1-85

10- 1985 GRIVER DRILLING SER. Lincoln
 date well completed firm name county well located

LANDOWNER: SHELL WESTERN
E & P, WEST MALLAWEN
FRACTIONATION PT. WAY/NO. 1
 (mailing address)
WELL LOCATION: SW/4 SW/4 NW/4
 sec. 16 T. 6 N. S. R. 8 E. W.

| description of formations encountered | from | to |
|---------------------------------------|------------|------------|
| <u>CLAY</u> | <u>0</u> | <u>4</u> |
| <u>SAND</u> | <u>4</u> | <u>42</u> |
| <u>SAND + pea Gravel</u> | <u>42</u> | <u>79</u> |
| <u>CLAY</u> | <u>79</u> | <u>104</u> |
| <u>CLAY + Rock</u> | <u>104</u> | <u>168</u> |
| <u>CLAY</u> | <u>168</u> | <u>190</u> |
| <u>SAND</u> | <u>190</u> | <u>210</u> |
| <u>SAND + pea Gravel</u> | <u>210</u> | <u>252</u> |
| <u>CLAY</u> | <u>252</u> | <u>301</u> |

WELL PURPOSE:
 (home, irrigation, municipal, industrial)

WELL COMPLETION DATA:

(1) diameter (inches) 10 3/4"

(2) total depth (feet) 252 ft.

(3) static water level (feet) 76.10 below above top of ground. 18-298"

(4) casing Steel 212 ft.
 (material) (depth)
10 3/4" if telescope see back.
 (size)

(5) screen 30 222
 (length) (depth to top)
6" 304 S.S. (.012)
 (size) (material)

(6) pump 15 150
 (HP) (yield gpm)
ELECT
 (type power)

(7) electric log YES
 (yes or no)
MISS. GEOL. SURVEY
 (organization running log)

(8) how well bottom plugged BACK
WASHT VALVE

CODED

RECEIVED


JAN 13 1986

DRILLERS REMARKS:

Department of Natural Resources
 Bureau of Land & Water Resources

If well telescopes please sketch and show depths.

GROUND LEVEL

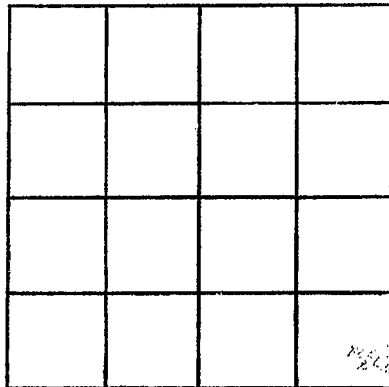

SECTION _____

Please indicate well location X.

ADDITIONAL INFORMATION

If more than one screen, show locations of each on sketch.