

MISSISSIPPI DEPARTMENT OF NATURAL RESOURCES
Bureau of Land and Water Resources
 Southport Mall
 P.O. Box 10631
 Jackson, Mississippi 39209
WATER WELL DRILLERS LOG

Lincoln
9-1-85
M37

9 — 1985 GRINER DRG. SERVICE LINCOLN
 date well completed firm name county well located

LANDOWNER:	description of formations encountered	from	to
<u>SHELL WESTERN</u>	<u>CLAY</u>	<u>0</u>	<u>4</u>
<u>E + P, W. MALLABEU</u>	<u>SAND</u>	<u>4</u>	<u>48</u>
<u>FRACTIONATION PLANT</u> (mailing address)	<u>SAND + PEA GRAVEL</u>	<u>42</u>	<u>79</u>
<u>WELL LOCATION: SW 1/4 BWPANWA</u>	<u>CLAY</u>	<u>79</u>	<u>104</u>
sec. <u>16</u> T. <u>6</u> N. R. <u>8</u> E. S. <u>5</u> W.	<u>CLAY + ROCK</u>	<u>104</u>	<u>168</u>
_____ miles _____ of _____ (distance) (direction) (nearest town)	<u>CLAY</u>	<u>168</u>	<u>190</u>
	<u>SAND</u>	<u>190</u>	<u>210</u>
	<u>SAND + PEA GRAVEL</u>	<u>210</u>	<u>252</u>
	<u>CLAY</u>	<u>252</u>	<u>301</u>

WELL PURPOSE: 2
 (home, irrigation, municipal, industrial)

WELL COMPLETION DATA:


- (1) diameter (inches) 10 3/4
- (2) total depth (feet) 252
- (3) static water level (feet) 76.10 below above top of ground.
- (4) casing steel 212
 (material) (depth)
10 3/4 if telescope see back.
 (size)
- (5) screen 30 220
 (length) (depth to top)
6" 304 SIS.
 (size) (material)
- (6) pump 15 150
 (HP) (yield gpm)
- ELECT.
 (type power)
- (7) electric log yes
 (yes or no)
MISS. GEOL. SURVEY
 (organization running log)
- (8) how well bottom plugged BACK
WASH VALVE + STUNGE

DRILLERS REMARKS:

RECEIVED
 SEP 30 1985

If well telescopes please
sketch and show depths.

GROUND LEVEL

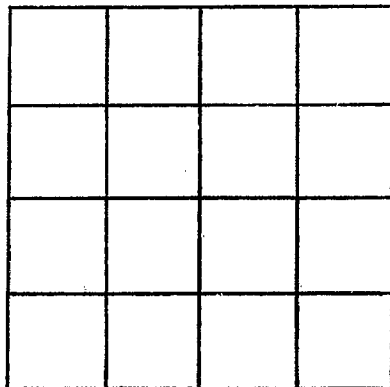

SECTION _____

Please indicate well location X.

ADDITIONAL INFORMATION

If more than one screen,
show locations of each on sketch.