

LINCOLN
M 48
05-16-72

MISSISSIPPI
 BOARD OF WATER COMMISSIONERS
 416 North State Street
 Jackson, Mississippi 39201

CODED

WATER WELL DRILLERS LOG

May 16 19 72 Grenn Water Well Contr. Lincoln
 date well completed firm name county well located

LANDOWNER:	description of formations encountered	from	to
Irene Smith			
Route 2	Red sand & gravel	0	82
Bogue Chitto, Miss.	Clay	82	100
(mailing address)			

WELL LOCATION:
 sec. 7 T. 6 N. R. 8 E
 5 miles S of Brookhaven
 (distance) (direction) (nearest town)

WELL PURPOSE:
 (home, irrigation, municipal, industrial)

- WELL COMPLETION DATA:**
- (1) diameter (inches) 6"
 - (2) total depth (feet) 100'
 - (3) static water level (feet) 55' below top of ground.
 - (4) casing PVC 74 (material), (depth)
 4" (size) if telescope see back.
 - (5) screen 6' 74' (length), (depth to top)
 .010 PVC (size), (material)
 - (6) pump 1/3 Sub. 7 (HP), (yield gpm)
 electric (type power)
 - (7) electric log no (yes or no)
 (organization running log)
 - (8) how well bottom plugged wood

CODED


JUNE 28 1972

DRILLERS REMARKS:

MISS. Bd. OF
 WATER COMMISSIONERS

If well telescopes please sketch and show depths.

GROUND LEVEL

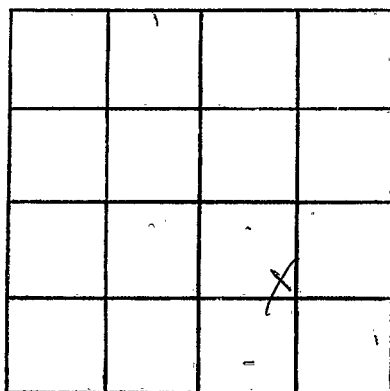

SECTION 7

Please indicate well location X.

ADDITIONAL INFORMATION

If more than one screen,
show locations of each on sketch.