

Lincoln
M 2001
3-19-76

MISSISSIPPI
BOARD OF WATER COMMISSIONERS
416 North State Street
Jackson, Mississippi 39201


WATER WELL DRILLERS LOG

Mr. 19 1976 Grenn Water Well Con. Lincoln
date well completed firm name county well located

LANDOWNER:	description of formations encountered	from	to
Joe Roberts Route 4, Box 126 Brookhaven, Miss. (mailing address)	Citronelle	1	64
WELL LOCATION:			
sec. 13 T 6 R 8 7 miles SE of Brookhaven (distance) (direction) (nearest town)			
WELL PURPOSE: home (home, irrigation, municipal, industrial)			
WELL COMPLETION DATA:			
(1) diameter (inches) 4			
(2) total depth (feet) 64			
(3) static water level (feet) 50 below top of ground			
(4) casing PVC 58 (material) (depth) 4" if telescope see back. (size)			
(5) screen 6' 58' (length) (depth to top) .010 PVC (size) (material)			
(6) pump did not install (HP) (yield gpm)			
(type power)			
(7) electric log no. (yes or no)			
(organization running log)			
(8) how well bottom plugged wood			
DRILLERS REMARKS:			
MAY 7 1976			
MISS. Bd. OF WATER COMMISSIONERS			

If well telescopes please sketch and show depths.

GROUND LEVEL

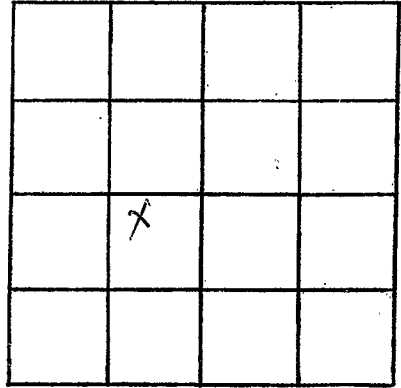

SECTION 13

Please indicate well location X.

ADDITIONAL INFORMATION

If more than one screen, show locations of each on sketch.