

LINCOLN
M 2002
4-8-76

MISSISSIPPI
 BOARD OF WATER COMMISSIONERS
 416 North State Street
 Jackson, Mississippi 39201

WATER WELL DRILLERS LOG

April 8 1976 Grenn Water Well Con. Lincoln
 date well completed firm name county well located

LANDOWNER: David Prather
Route 4, Box 102
Brookhaven, Miss.
 (mailing address)

description of formations encountered
Citronelle
 from 1 to 56

WELL LOCATION:
 sec. 12 T. 6 N R. 8 E
 S W
7 miles SE of Brookhaven
 (distance) (direction) (nearest town)

WELL PURPOSE: home
 (home, irrigation, municipal, industrial)


- WELL COMPLETION DATA:
- (1) diameter (inches) 4
 - (2) total depth (feet) 56
 - (3) static water level (feet) 25 below above top of ground.
 - (4) casing PVC 50
 (material) (depth)
4"
 (size) if telescope see back.
 - (5) screen 6' 50'
 (length) (depth to top)
.010 PVC
 (size) (material)
 - (6) pump did not install
 (HP) (yield gpm)
 (type power)
 - (7) electric log no
 (yes or no)
 (organization running log)
 - (8) how well bottom plugged back wash valve

DRILLERS REMARKS:

RECORDED
 INDEXED
 MAY - 7 1976
 MISS. Bd. of Water Comm.

If well telescopes please sketch and show depths.

GROUND LEVEL

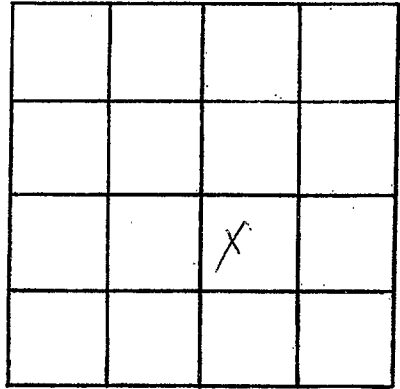

SECTION 12

Please indicate well location X.

ADDITIONAL INFORMATION

If more than one screen, show locations of each on sketch.