

Lincoln
 M 2003
 7-8-76

MISSISSIPPI
 BOARD OF WATER COMMISSIONERS
 416 North State Street
 Jackson, Mississippi 39201

WATER WELL DRILLERS LOG

8 July 1976 *Amor-Raker Well Co* Lincoln
 date well completed firm name county well located

LANDOWNER:	description of formations encountered	from	to
<i>Ozie Hayes</i>			
<i>Regene Chitto</i> (mailing address)	<i>clay</i>	<i>0</i>	<i>25</i>
	<i>shale</i>	<i>25</i>	<i>40</i>
	<i>sand</i>	<i>40</i>	<i>74</i>

WELL LOCATION:
 sec. 31 T. 6 N. R. 8 E
8.1 miles E of B.C.
 (distance) (direction) (nearest town)

WELL PURPOSE:
 (home, irrigation, municipal, industrial)

- WELL COMPLETION DATA:
- (1) diameter (inches) 4
 - (2) total depth (feet) 74
 - (3) static water level (feet) _____ below above top of ground.
 - (4) casing 41 68
 (material) (depth)
 - (size) If telescope see back.
 - (5) screen 6 68
 (length) (depth to top)
 - (size) (material)
 - (6) pump 1/2 8
 (HP) (yield gpm)
 - (type power) split
 - (7) electric log _____ (yes or no)
 - (organization running log) _____
 - (8) how well bottom plugged wood


DRILLERS REMARKS:

RECEIVED
 SEP - 1 1976

MISS. BD. OF WATER COMMISSIONERS

If well telescopes please sketch and show depths.

GROUND LEVEL

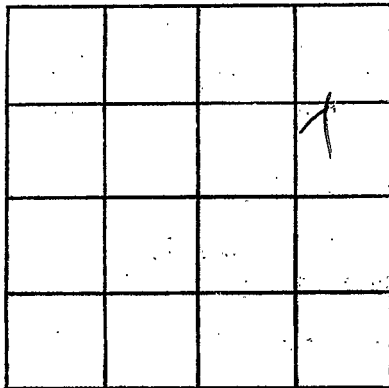

SECTION 3/

Please indicate well location X.

ADDITIONAL INFORMATION

If more than one screen, show locations of each on sketch.