

LINCOLN  
M 2004  
9-25-75

MISSISSIPPI  
BOARD OF WATER COMMISSIONERS  
416 North State Street  
Jackson, Mississippi 39201

WATER WELL DRILLERS LOG

Sept 25 1975 Reynolds Drilling Lincoln  
date well completed firm name county well located

LANDOWNER:	description of formations encountered	from	to
(mailing address)			
Charles Hart	Red Clay	0	12
Pt. Brookhaven	Chalky sand	17	50
	Sand & pe gravel	50	70
WELL LOCATION:			
sec. <u>21</u> T <u>6</u> N R <u>9</u> E			
<u>4</u> miles <u>N-NW</u> of <u>Bozinger</u>			
(distance) (direction) (nearest town)			
WELL PURPOSE: <u>Home</u>			
(home, irrigation, municipal, industrial)			
WELL COMPLETION DATA:			
(1) diameter (inches) <u>4"</u>			
(2) total depth (feet) <u>70</u>			
(3) static water level (feet) <u>45'</u> below top of ground.			
(4) casing <u>Plastic</u> <u>collar</u>			
(material) (depth)			
_____ if telescope see back.			
(size)			
(5) screen <u>1"</u> <u>64'</u>			
(length) (depth to top)			
<u>4'</u> <u>Plastic</u>			
(size) (material)			
(6) pump <u>30 gpm</u> <u>8</u>			
(HP) (yield gpm)			
<u>Electric</u>			
(type power)			
(7) electric log <u>no</u>			
(yes or no)			
_____			
(organization running log)			
(8) how well bottom plugged <u>Wooded Plug</u>			
DRILLERS REMARKS:			


RECEIVED

JAN 12 1976

MISS. Bd. OF WATER COMMISSIONERS

If well telescopes please sketch and show depths.

GROUND LEVEL

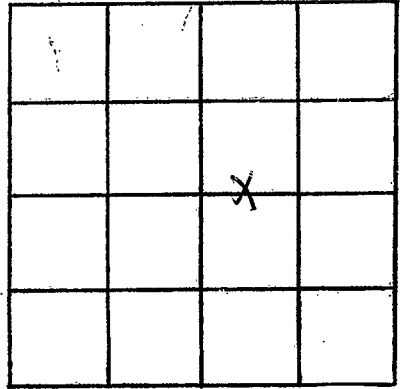

SECTION 21

Please indicate well location X.

ADDITIONAL INFORMATION

If more than one screen,  
show locations of each on sketch.