

Lincoln
M 2005
8/17/76

MISSISSIPPI
 BOARD OF WATER COMMISSIONERS
 416 North State Street
 Jackson, Mississippi 39201

WATER WELL DRILLERS LOG

17 Aug 1976
 date well completed

J.T. Construction Lincoln
 firm name county well located

LANDOWNER:
Alex Brahms
Brookhaven, Miss
 (mailing address)

description of formations encountered	from	to
<u>clay</u>	<u>0</u>	<u>70</u>
<u>chert</u>	<u>70</u>	<u>55</u>
<u>good depth</u>	<u>55</u>	<u>70</u>
<u>chert</u>	<u>70</u>	<u>80</u>
<u>rock</u>	<u>80</u>	<u>135</u>

WELL LOCATION:
 sec. 7 T. 6 N. R. 8 E.
 (distance) miles (direction) of (nearest town)

WELL PURPOSE:
 (home, irrigation, municipal, industrial)

WELL COMPLETION DATA:

(1) diameter (inches) 4

(2) total depth (feet) 135

(3) static water level (feet) 25 below top of ground.

(4) casing PI (129 depth)
 (material) (depth)

(size) If telescope see back.

(5) screen 6 (129 depth to top)
 (length) (depth to top)

4 (PI material)
 (size) (material)

(6) pump 8 (8 yield gpm)
 (HP) (yield gpm)

elect
 (type power)

(7) electric log _____
 (yes or no)

 (organization running log)

(8) how well bottom plugged wood


RECEIVED

OCT 26 1976

DRILLERS REMARKS:

If well telescopes please sketch and show depths.

GROUND LEVEL

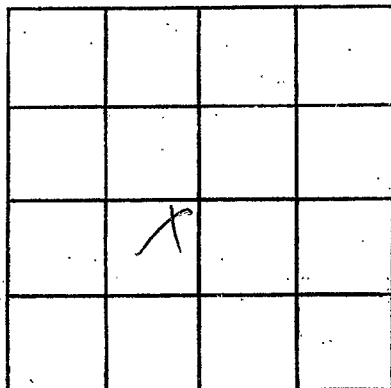

SECTION 7

Please indicate well location X.

ADDITIONAL INFORMATION

If more than one screen, show locations of each on sketch.