

Lincoln
M 2007
2-9-77

MISSISSIPPI
 BOARD OF WATER COMMISSIONERS
 416 North State Street
 Jackson, Mississippi 39201

WATER WELL DRILLERS LOG

Feb. 9 1977 Grenn Water Well Cont. Lincoln
 date well completed firm name county well located


LANDOWNER: <u>Mary Lee Bardwell</u>	description of formations encountered	from	to
<u>Route 2, Bogue Chitto, Miss.</u>			
(mailing address)	<u>Citronelle</u>	<u>1</u>	<u>55</u>
WELL LOCATION: sec. <u>21</u> T. <u>6</u> N. R. <u>8</u> E S W <u>3</u> miles NE of <u>Bogue Chitto</u> (distance) (direction) (nearest town)			
WELL PURPOSE: <u>home</u> (home, irrigation, municipal, industrial)			
WELL COMPLETION DATA:			
(1) diameter (inches) <u>6</u>			
(2) total depth (feet) <u>55</u>			
(3) static water level (feet) <u>33</u> below top of ground.			
(4) casing <u>PVC</u> <u>4 1/2</u> (material) (depth) <u>4"</u> (size) If telescope see back.			
(5) screen <u>12'</u> <u>43'</u> (length) (depth to top) <u>.010</u> <u>PVC</u> (size) (material)			
(6) pump <u>1/2 HP sub 10</u> (HP) (yield gpm) <u>electricity</u> (type power)			
(7) electric log <u>no</u> (yes or no)			
(organization running log)			
(8) how well bottom plugged <u>back wash valve</u>			
DRILLERS REMARKS:			

RECEIVED
 MAR 25 1977

MISS. BD. OF WATER COMMISSIONERS

If well telescopes please sketch and show depths.

GROUND LEVEL

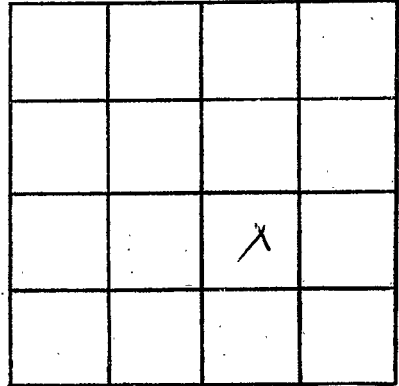

SECTION 21

Please indicate well location X.

ADDITIONAL INFORMATION

If more than one screen, show locations of each on sketch.