

Lincoln  
M 2008  
2-11-77

MISSISSIPPI  
 BOARD OF WATER COMMISSIONERS  
 416 North State Street  
 1301 Jackson, Mississippi 39201

WATER WELL DRILLERS LOG

Feb. 11 1977 Grenn Water Well Contr. Lincoln  
 date well completed firm name county well located

LANDOWNER: Doyle Jergins	description of formations encountered	from	to
Route 1			
Bogue Chitto, Miss. (mailing address)			
<b>WELL LOCATION:</b>			
sec. <u>25</u> T <u>6</u> N R. <u>8</u> E			
<u>6</u> miles <u>E</u> of <u>Bogue Chitto</u>			
(distance) (direction) (nearest town)			
<b>WELL PURPOSE: home</b> (home, irrigation, municipal, industrial)			
<b>WELL COMPLETION DATA:</b>			
(1) diameter (inches) <u>6</u>			
(2) total depth (feet) <u>110</u>			
(3) static water level (feet) <u>55</u> below top of ground.			
(4) casing <u>PVC</u> , <u>104'</u> (material) (depth)			
<u>4"</u> (size) If telescope see back.			
(5) screen <u>6'</u> , <u>104'</u> (length) (depth to top)			
<u>.010</u> , <u>PVC</u> (size) (material)			
(6) pump <u>1/2 sub 10</u> (HP) (yield gpm)			
<u>electricity</u> (type power)			
(7) electric log <u>no</u> (yes or no)			
<u>(organization running log)</u>			
(8) how well bottom plugged <u>back wash valve</u>			
<b>DRILLERS REMARKS:</b>			


**RECEIVED**

MAR 25 1977

MISS. RD. OF WATER COMMISSIONERS

If well telescopes please sketch and show depths.

GROUND LEVEL

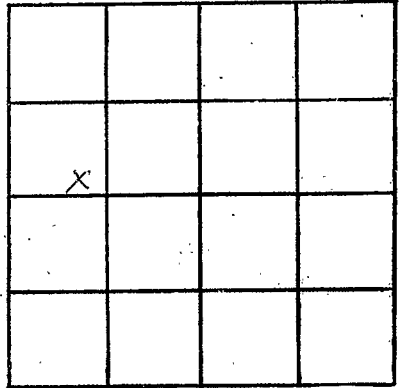

SECTION 25

Please indicate well location X.

ADDITIONAL INFORMATION

If more than one screen, show locations of each on sketch.