

LINCOLN  
M 2009  
3-17-77

MISSISSIPPI  
 BOARD OF WATER COMMISSIONERS  
 416 North State Street  
 Jackson, Mississippi 39201

WATER WELL DRILLERS LOG

March 17 19 77 Grenn Water Well Cont. Lincoln  
 date well completed firm name county well located


LANDOWNER: <u>Judy McCullough</u>	description of formations encountered	from	to
Route 2			
<u>Bogue Chitto, Miss.</u> (mailing address)	<u>Citronelle</u>	<u>1</u>	<u>70</u>
<b>WELL LOCATION:</b>			
sec. <u>35</u> T <u>6</u> <u>N</u> R <u>8</u> <u>E</u> S W			
<u>4</u> miles <u>E</u> of <u>Bogue Chitto</u> (distance) (direction) (nearest town)			
<b>WELL PURPOSE:</b> <u>home</u> (home, irrigation, municipal, industrial)			
<b>WELL COMPLETION DATA:</b>			
(1) diameter (inches) <u>6</u>			
(2) total depth (feet) <u>70</u>			
(3) static water level (feet) <u>20</u> below top of ground. above			
(4) casing <u>PVC</u> , <u>64</u> (material) (depth) <u>4"</u> (size) if telescope see back.			
(5) screen <u>6"</u> , <u>64"</u> (length) (depth to top) <u>.010</u> , <u>PVC</u> (size) (material)			
(6) pump <u>did not install</u> (HP) (yield gpm)			
(type power)			
(7) electric log <u>no</u> (yes or no)			
(organization running log)			
(8) how well bottom plugged <u>back wash valve</u>			
DRILLERS REMARKS:			

RECEIVED  
 APR 22 1977

MISS. DE. OF WATER

If well telescopes please sketch and show depths.

GROUND LEVEL

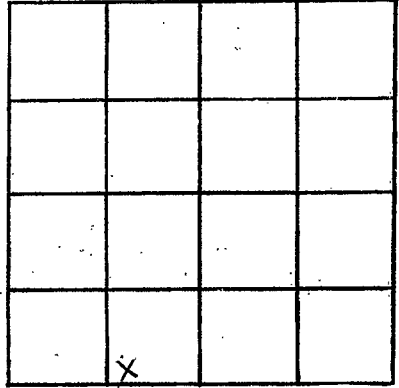

SECTION 35

Please indicate well location X.

ADDITIONAL INFORMATION

If more than one screen, show locations of each on sketch.